


TOWNSHIP 10 SOUTH, RANGE 19 EAST, W.M.

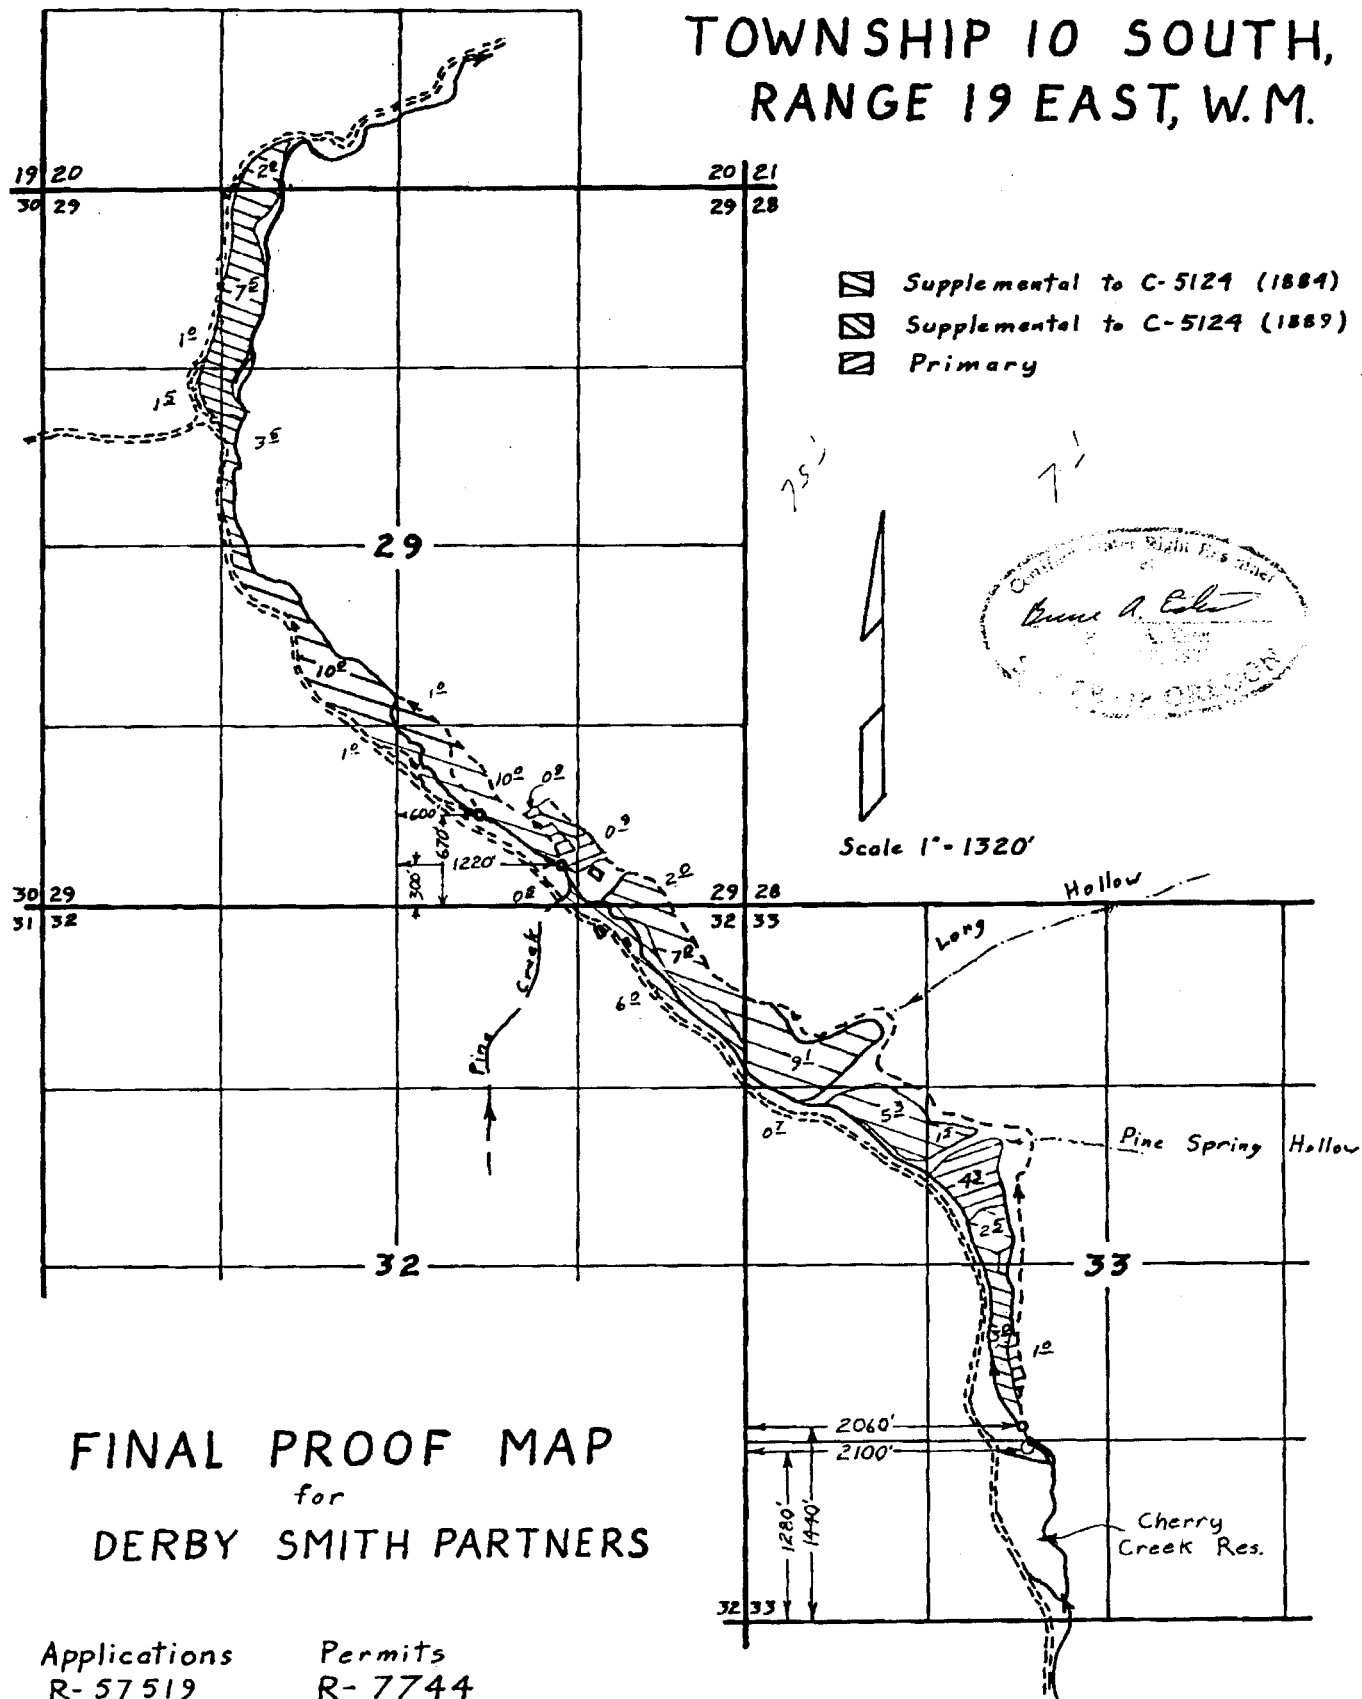

Surveyed July 31, 1991

This map is for the purpose of locating a water right only and has no intent to provide legal dimensions or the location of property lines.