


TOWNSHIP 10 SOUTH, RANGE 19 EAST, W.M.

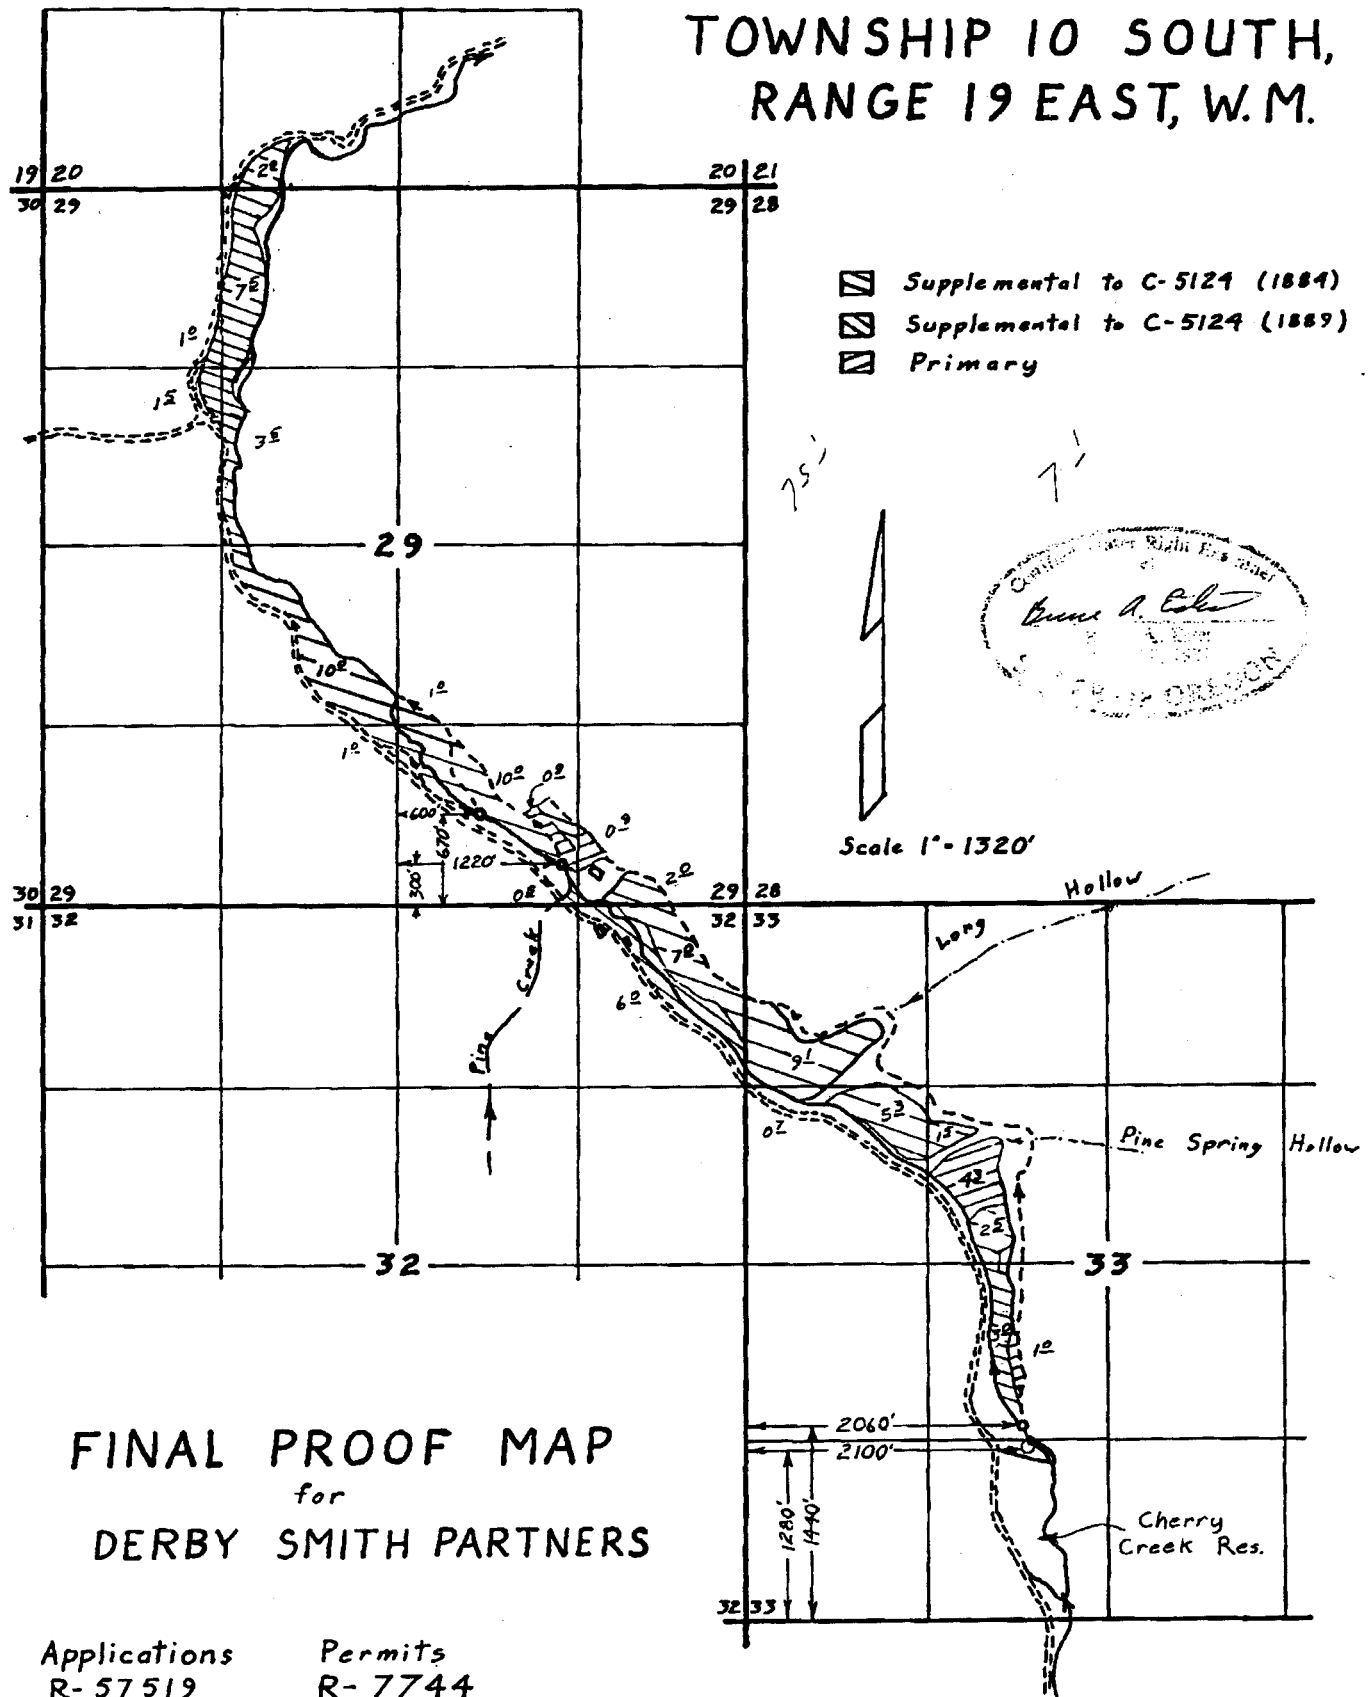

FINAL PROOF MAP for DERBY SMITH PARTNERS

Applications
R- 57519
57520

Permits
R- 7744
43718

Surveyed July 31, 1991

This map is for the purpose of locating a water right, only and has no intent to provide legal dimensions or the location of property lines.