

Scale 1" = 1320'


POD NOT ON PERMIT 42833
 L 48540?

- Permit 42833 Primary 251.42
- Permit 42833 Supplemental - 293.12
- Permit 48540 Supplemental

This map based on Bridge Creek adjudication map.

FINAL PROOF MAP
 for
WILLIAM L. SMITH PROPERTIES, INC.

Application R-57142 Permit R-7015
 57143 42833
 R-67960 R-9896
 67961 48540

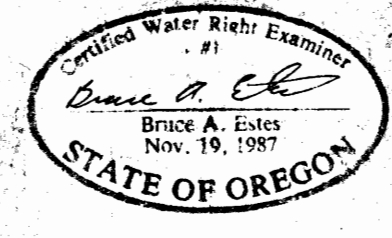

This map is for the purpose of locating a water right only and has no intent to provide legal dimensions or the location of property lines.