


T.6S. R.1&2W. W.M.

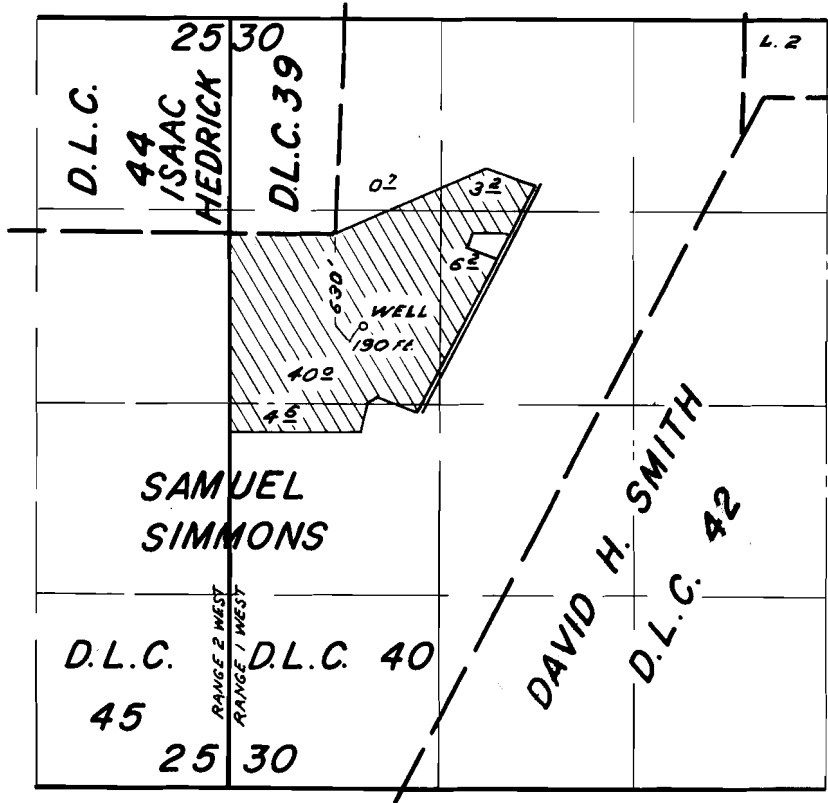

**FINAL PROOF SURVEY**  
UNDER

Application No. G-2007 Permit No. G-1845  
IN NAME OF

LE ROY BEALS

Surveyed JUNE 16 1965 by L. COLEBANK