


# T. 4 S. R. 1 E. W. M.

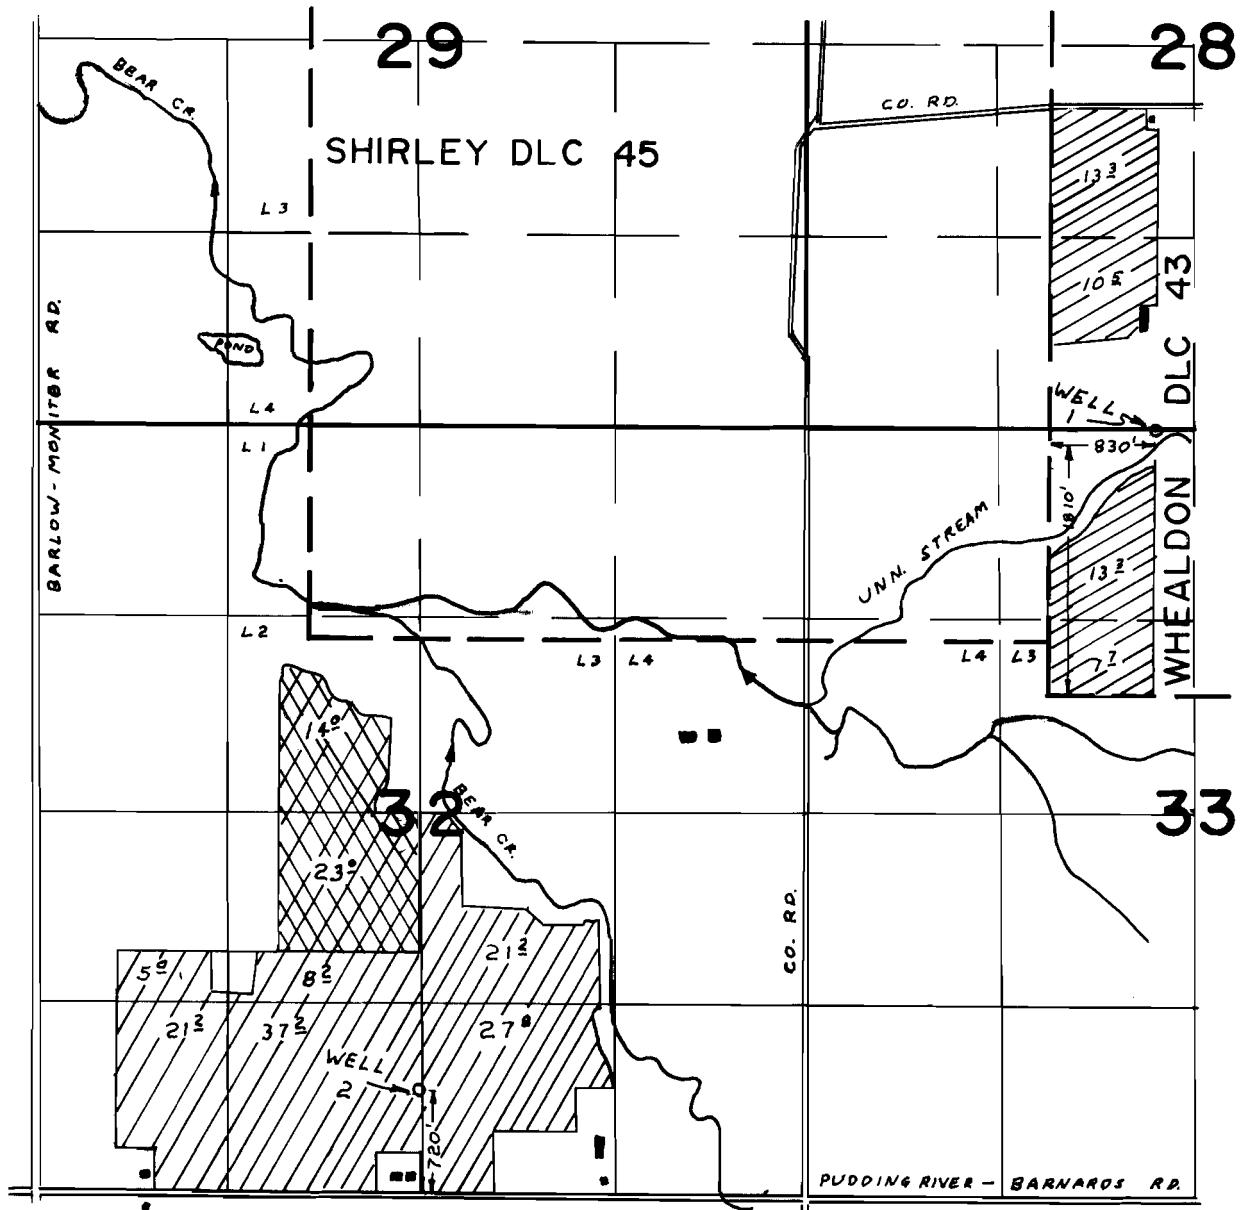

## FINAL PROOF SURVEY UNDER

Application No. G-5629... Permit No. G-4921...  
IN NAME OF

TWIN CREEK FARMS, INC.....

Surveyed SEP. 23. 1974., by L. H. NUNN.....