


T. 35S., R. 33E., W.M.

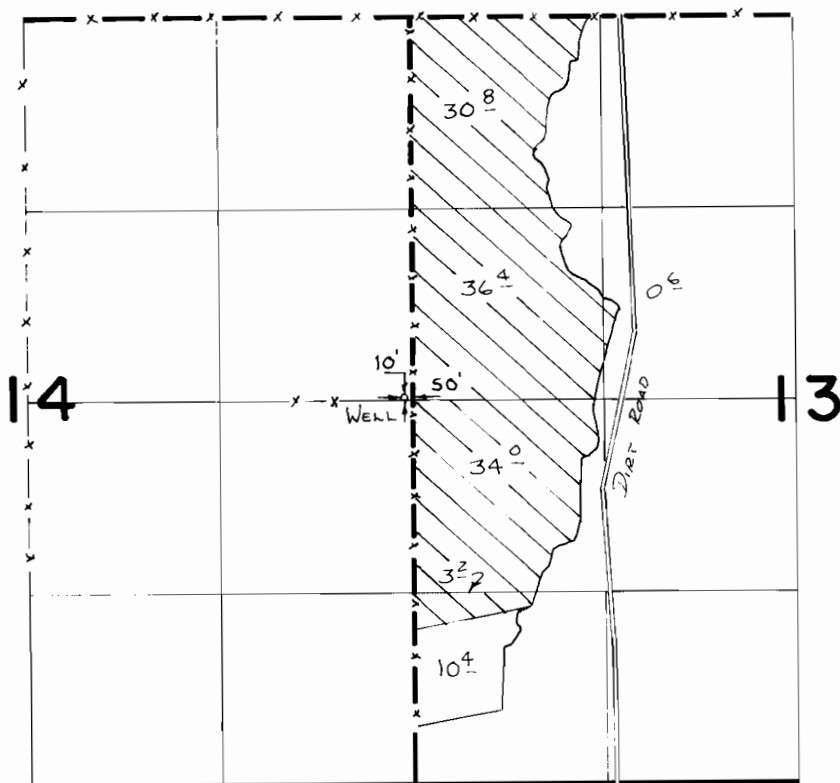

SCALE 1"=1320

FINAL PROOF SURVEY
UNDER

Application No. **G-8657** Permit No. **G-8116**
IN NAME OF

HENRY BLAIR

Surveyed 7-18-1988, by V.L. Church