

Form A1-187
March 1961

UNITED STATES
DEPARTMENT OF THE INTERIOR
BUREAU OF LAND MANAGEMENT


SECTION

S 12

Oregon State Water Filings

TOWNSHIP 32 S, RANGE 43 E, W. M.

North

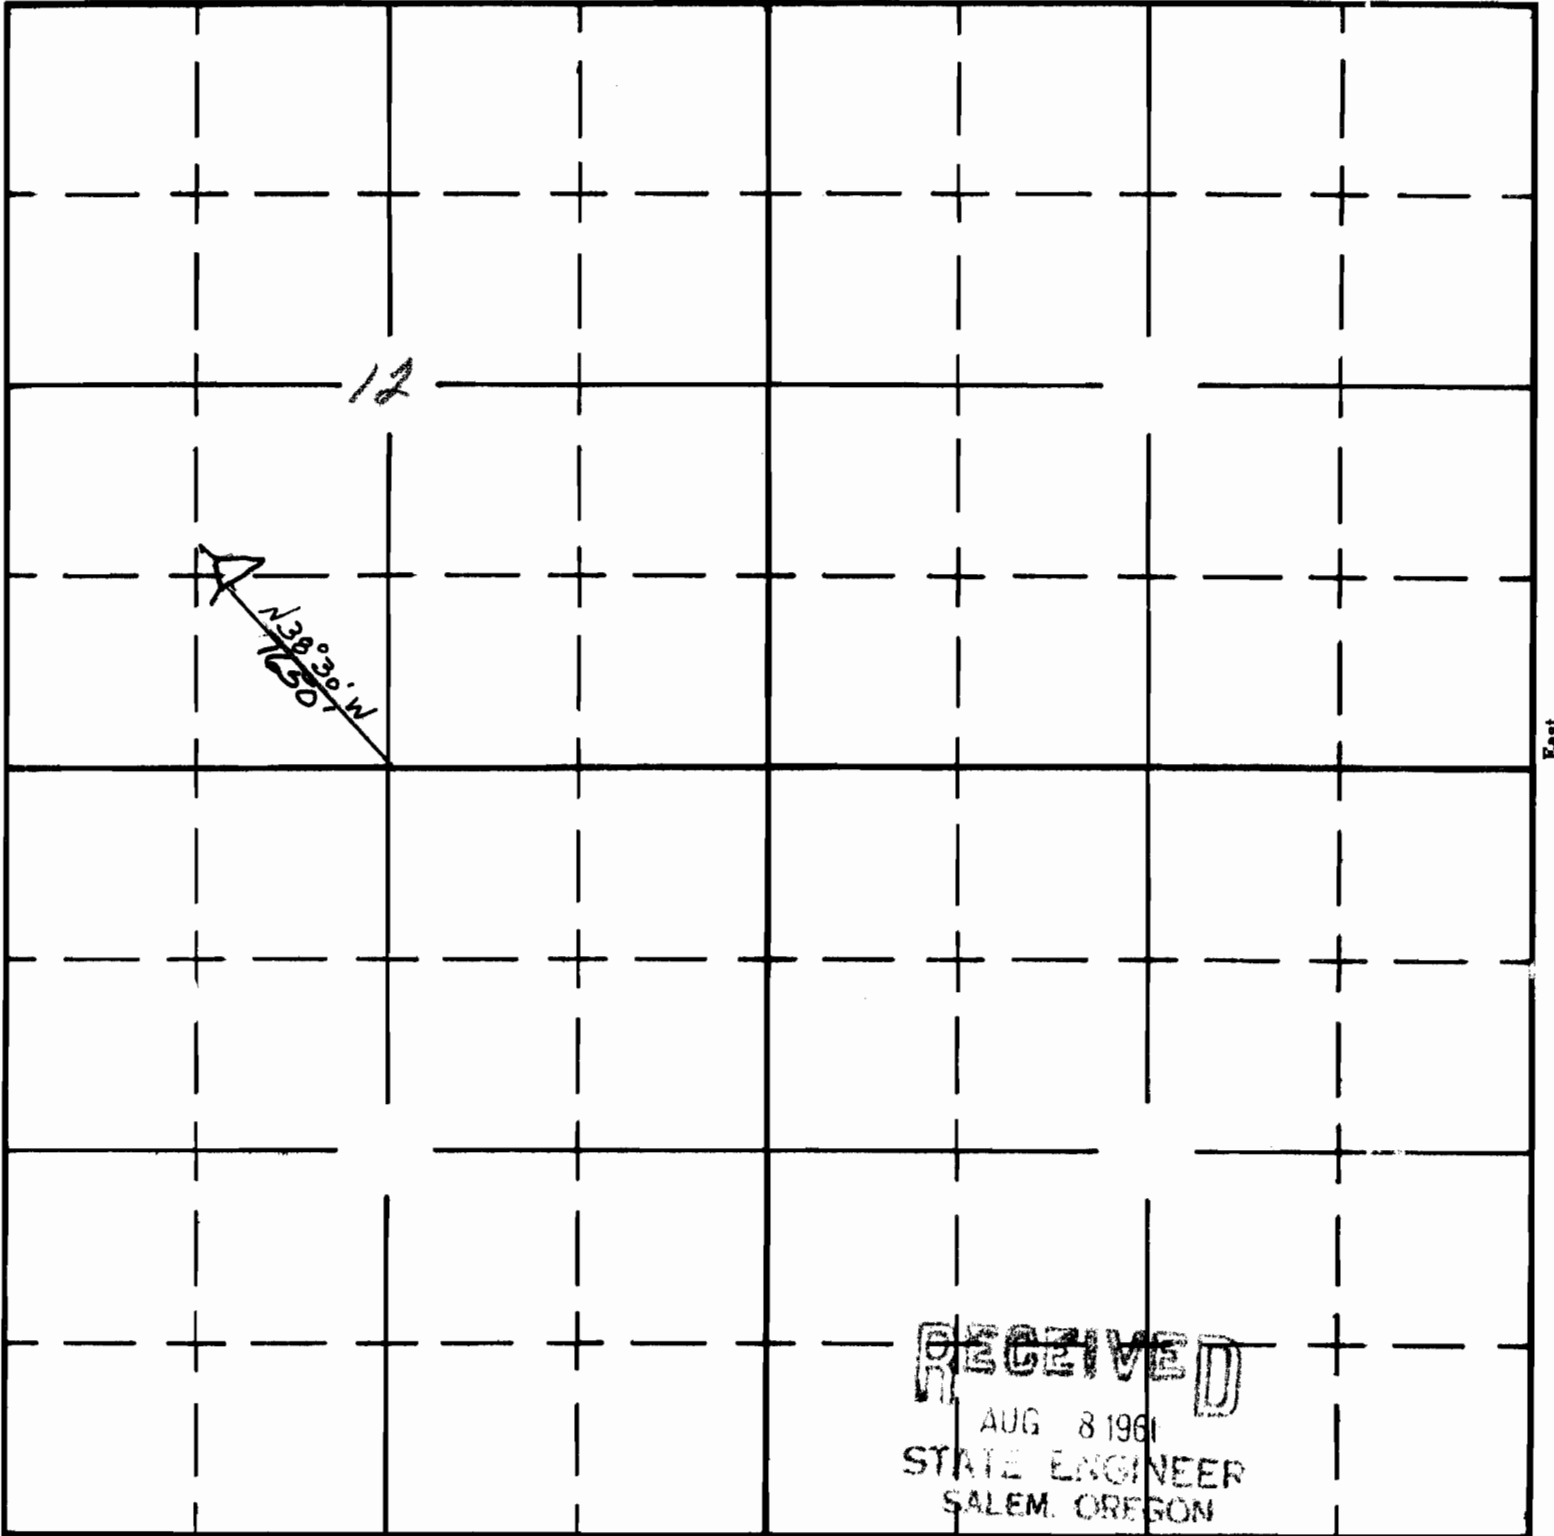

South

APPLICATION No. R-36615
PERMIT No. R-2693