


UNITED STATES
DEPARTMENT OF THE INTERIOR
BUREAU OF LAND MANAGEMENT

SECTION

19

Oregon State Water Filings

TOWNSHIP 33 S, RANGE 45 E, W. M.

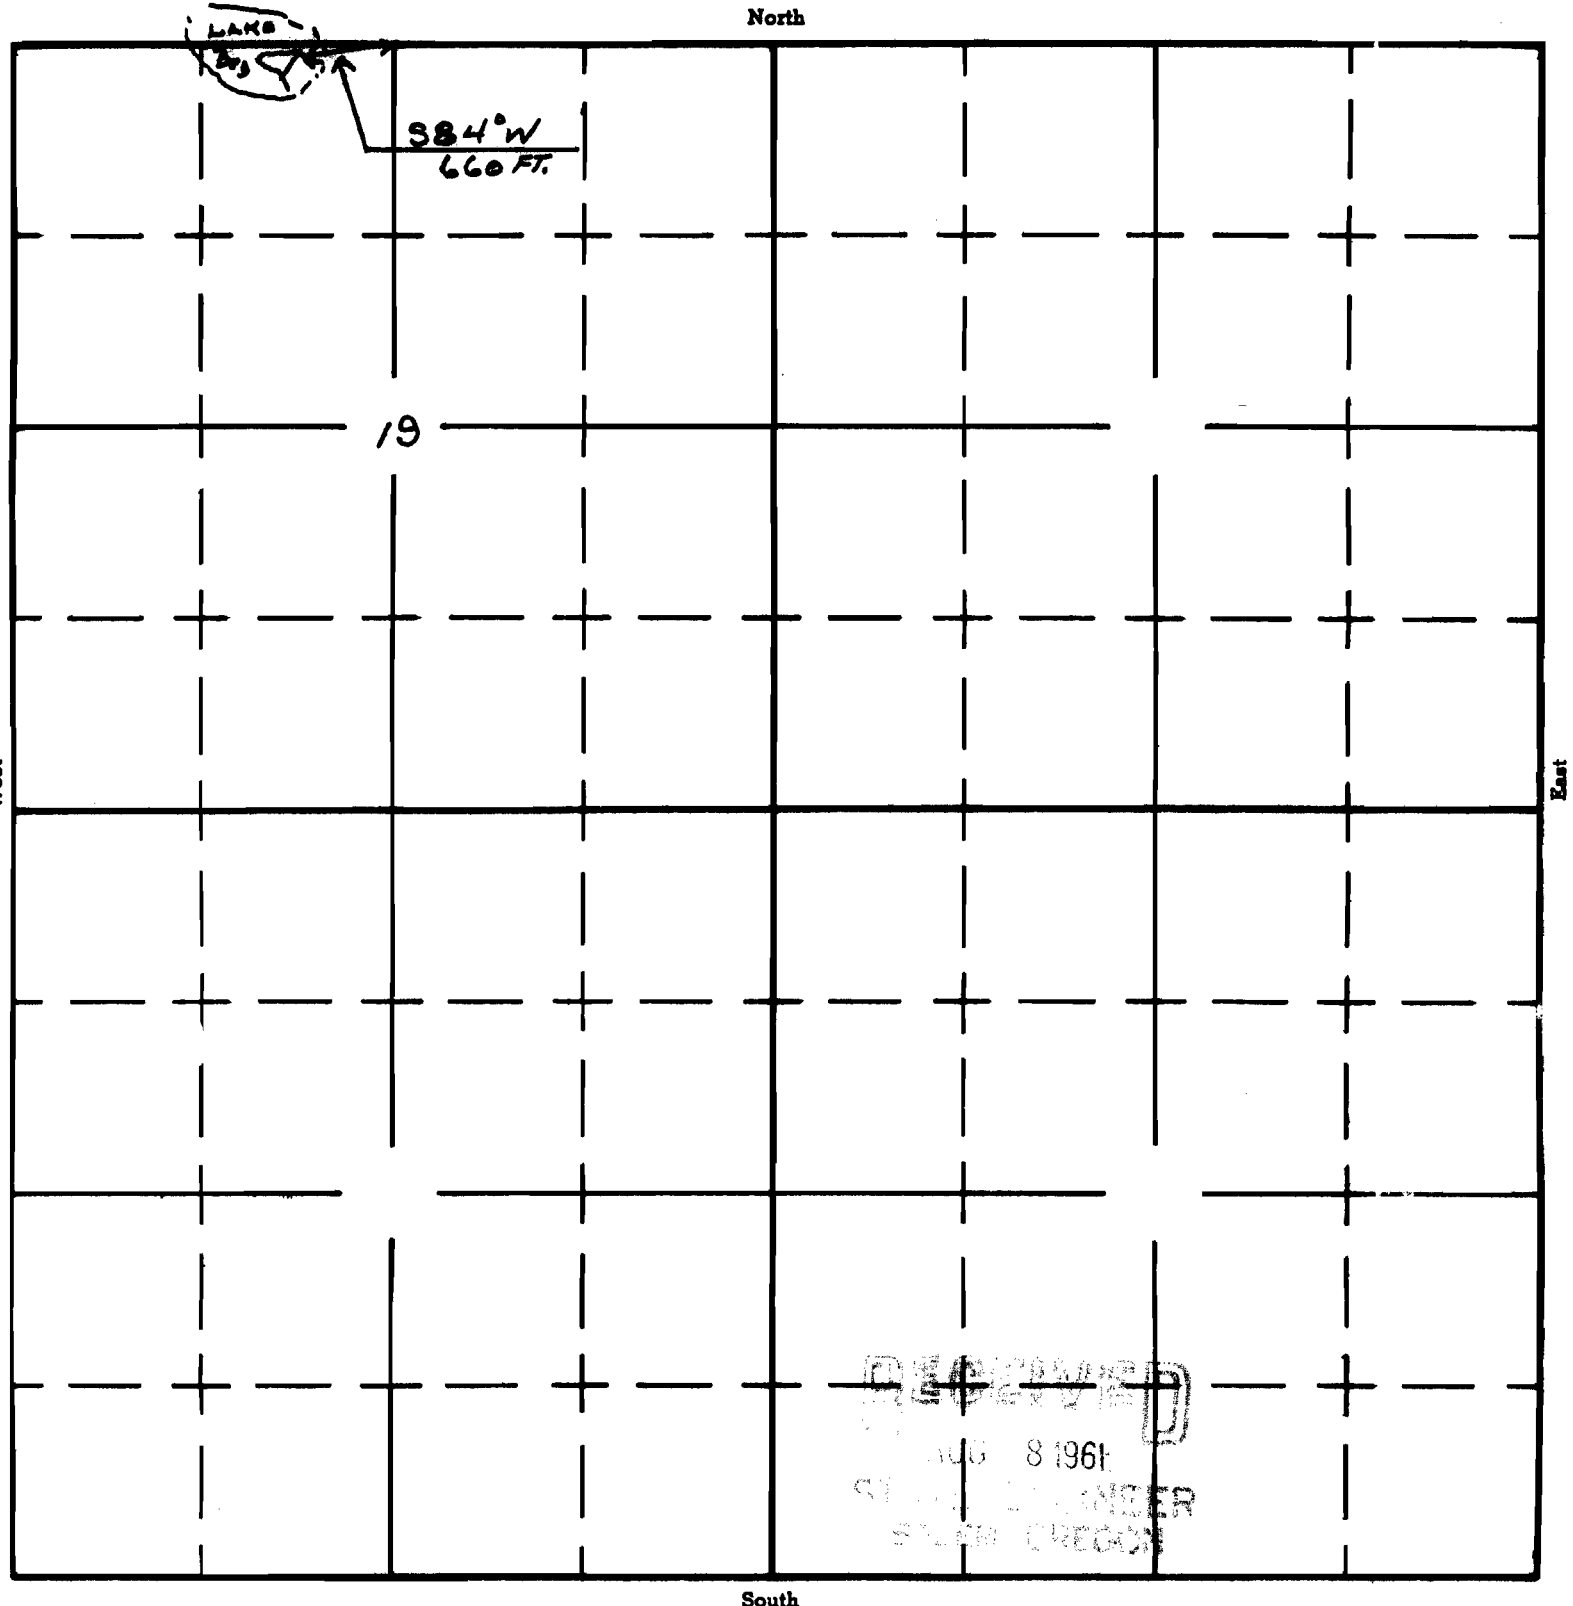

South

APPLICATION No. R-36633

PERMIT No. R-3646