

Form AI-187
March 1961

UNITED STATES
DEPARTMENT OF THE INTERIOR
BUREAU OF LAND MANAGEMENT


SECTION

S/

Oregon State Water Filings

TOWNSHIP 32S, RANGE 42E, W. M.

North

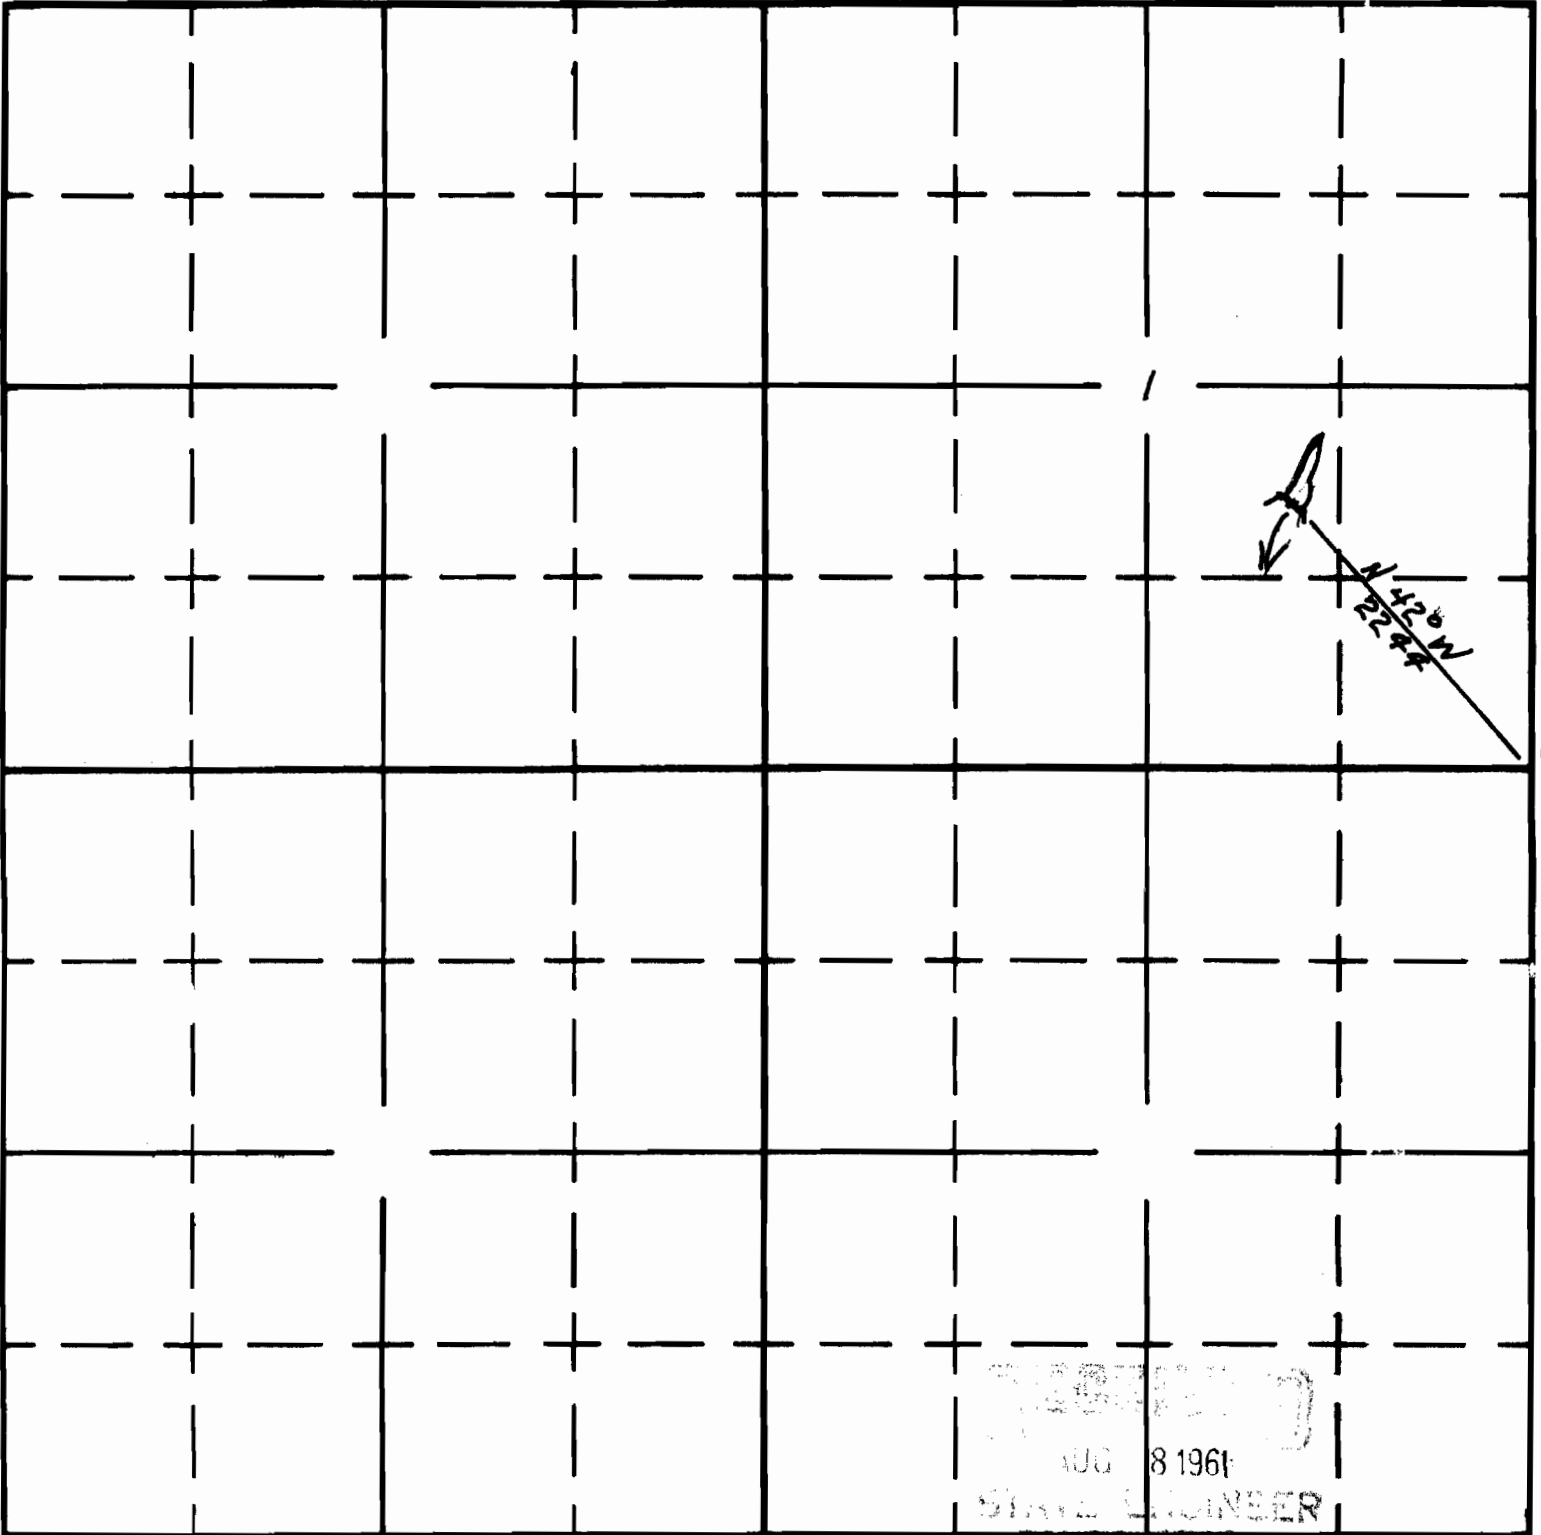

South

APPLICATION No. R-36640

PERMIT No. R-5794