

UNITED STATES
DEPARTMENT OF THE INTERIOR
BUREAU OF LAND MANAGEMENT

SECTION


Oregon State Water Filings

815

TOWNSHIP 30S, RANGE 41E, W. M.

Figure Res #2

North

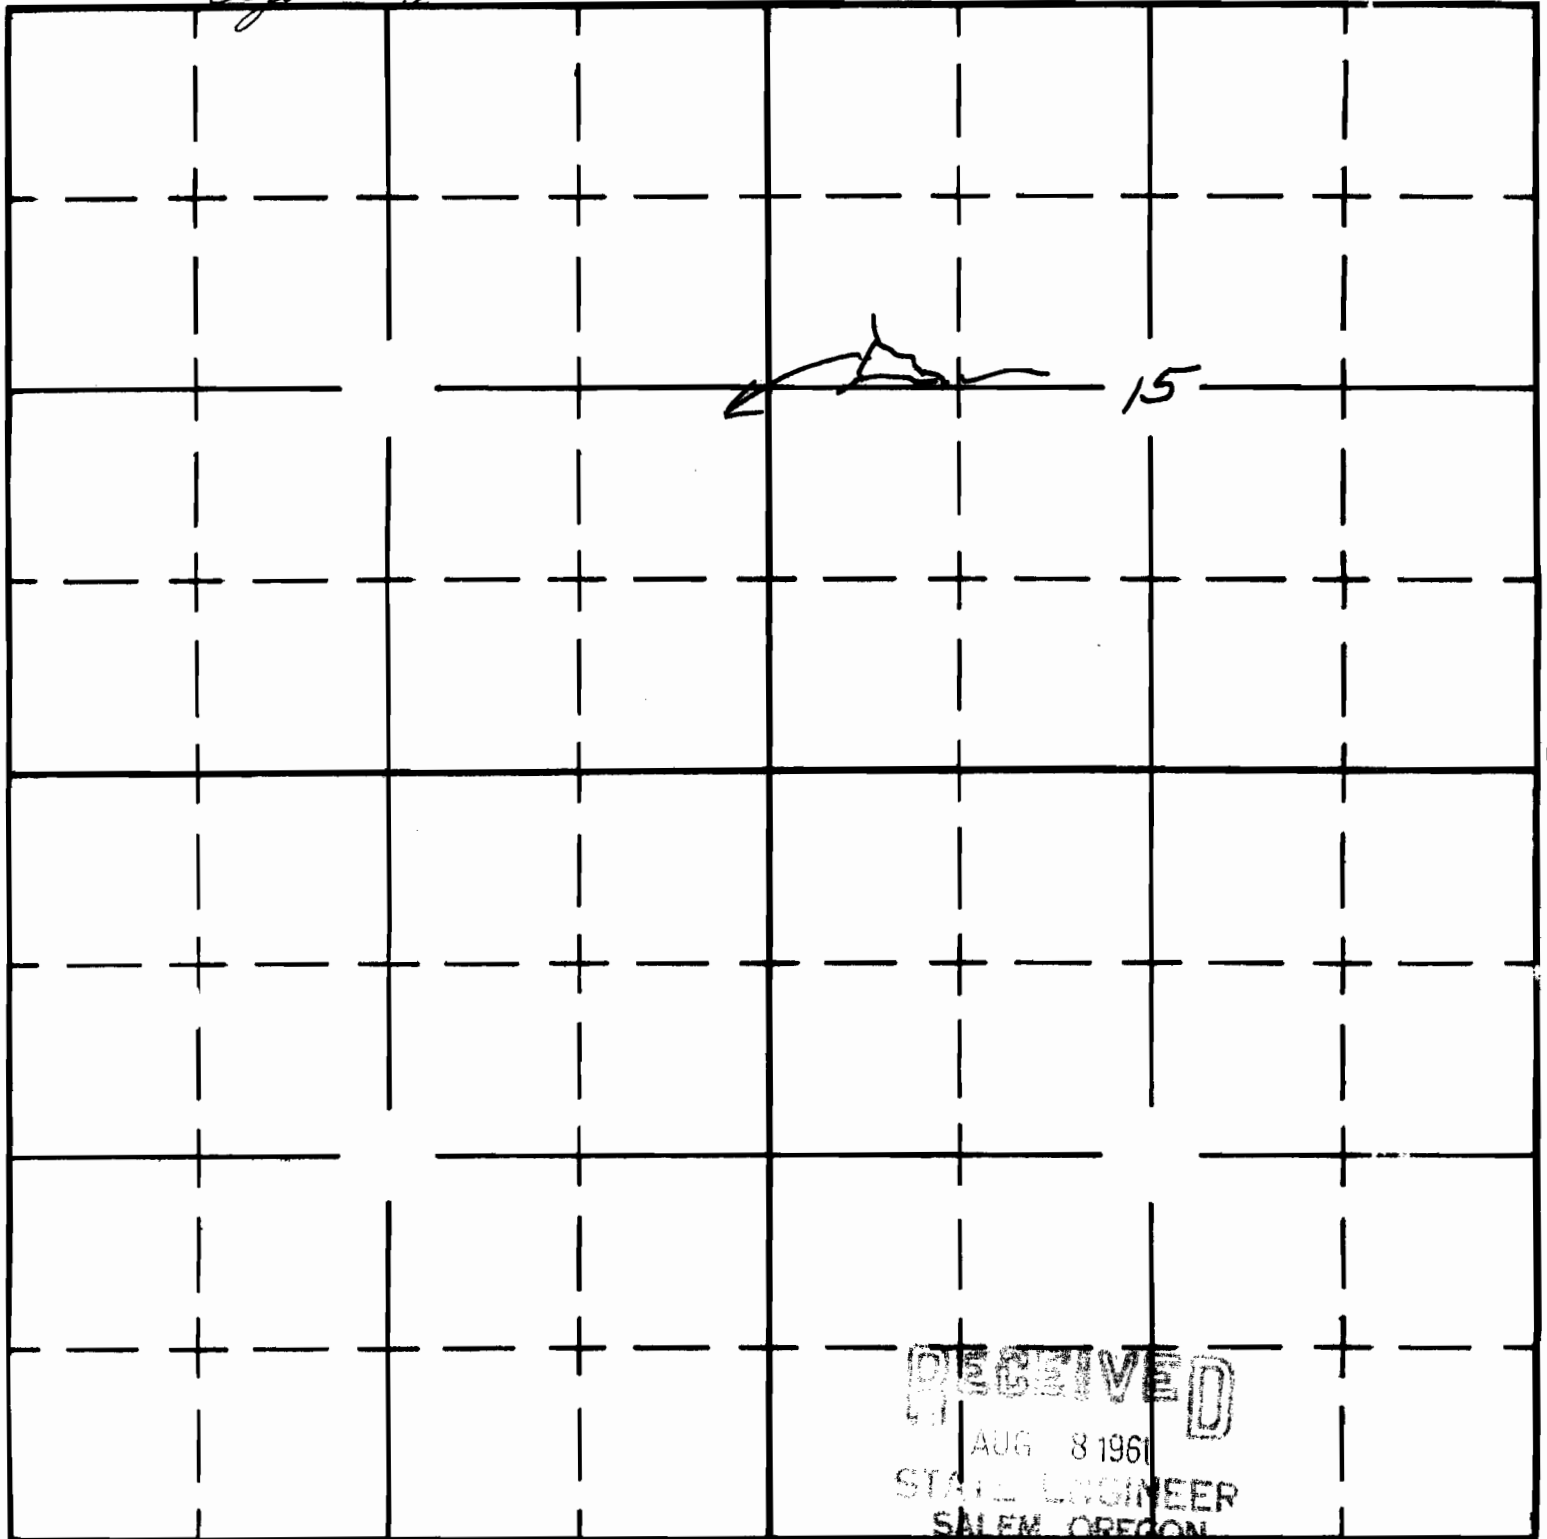

South

APPLICATION No. A-36727
PERMIT No. R-4291