

UNITED STATES
DEPARTMENT OF THE INTERIOR
BUREAU OF LAND MANAGEMENT


Corrective
RECEIVED
OCT 17 1968
STATE ENGINEER
SALEM, OREGON

SECTION 5

Oregon State Water Filings

TOWNSHIP 27s, RANGE 37E, W. M.

North

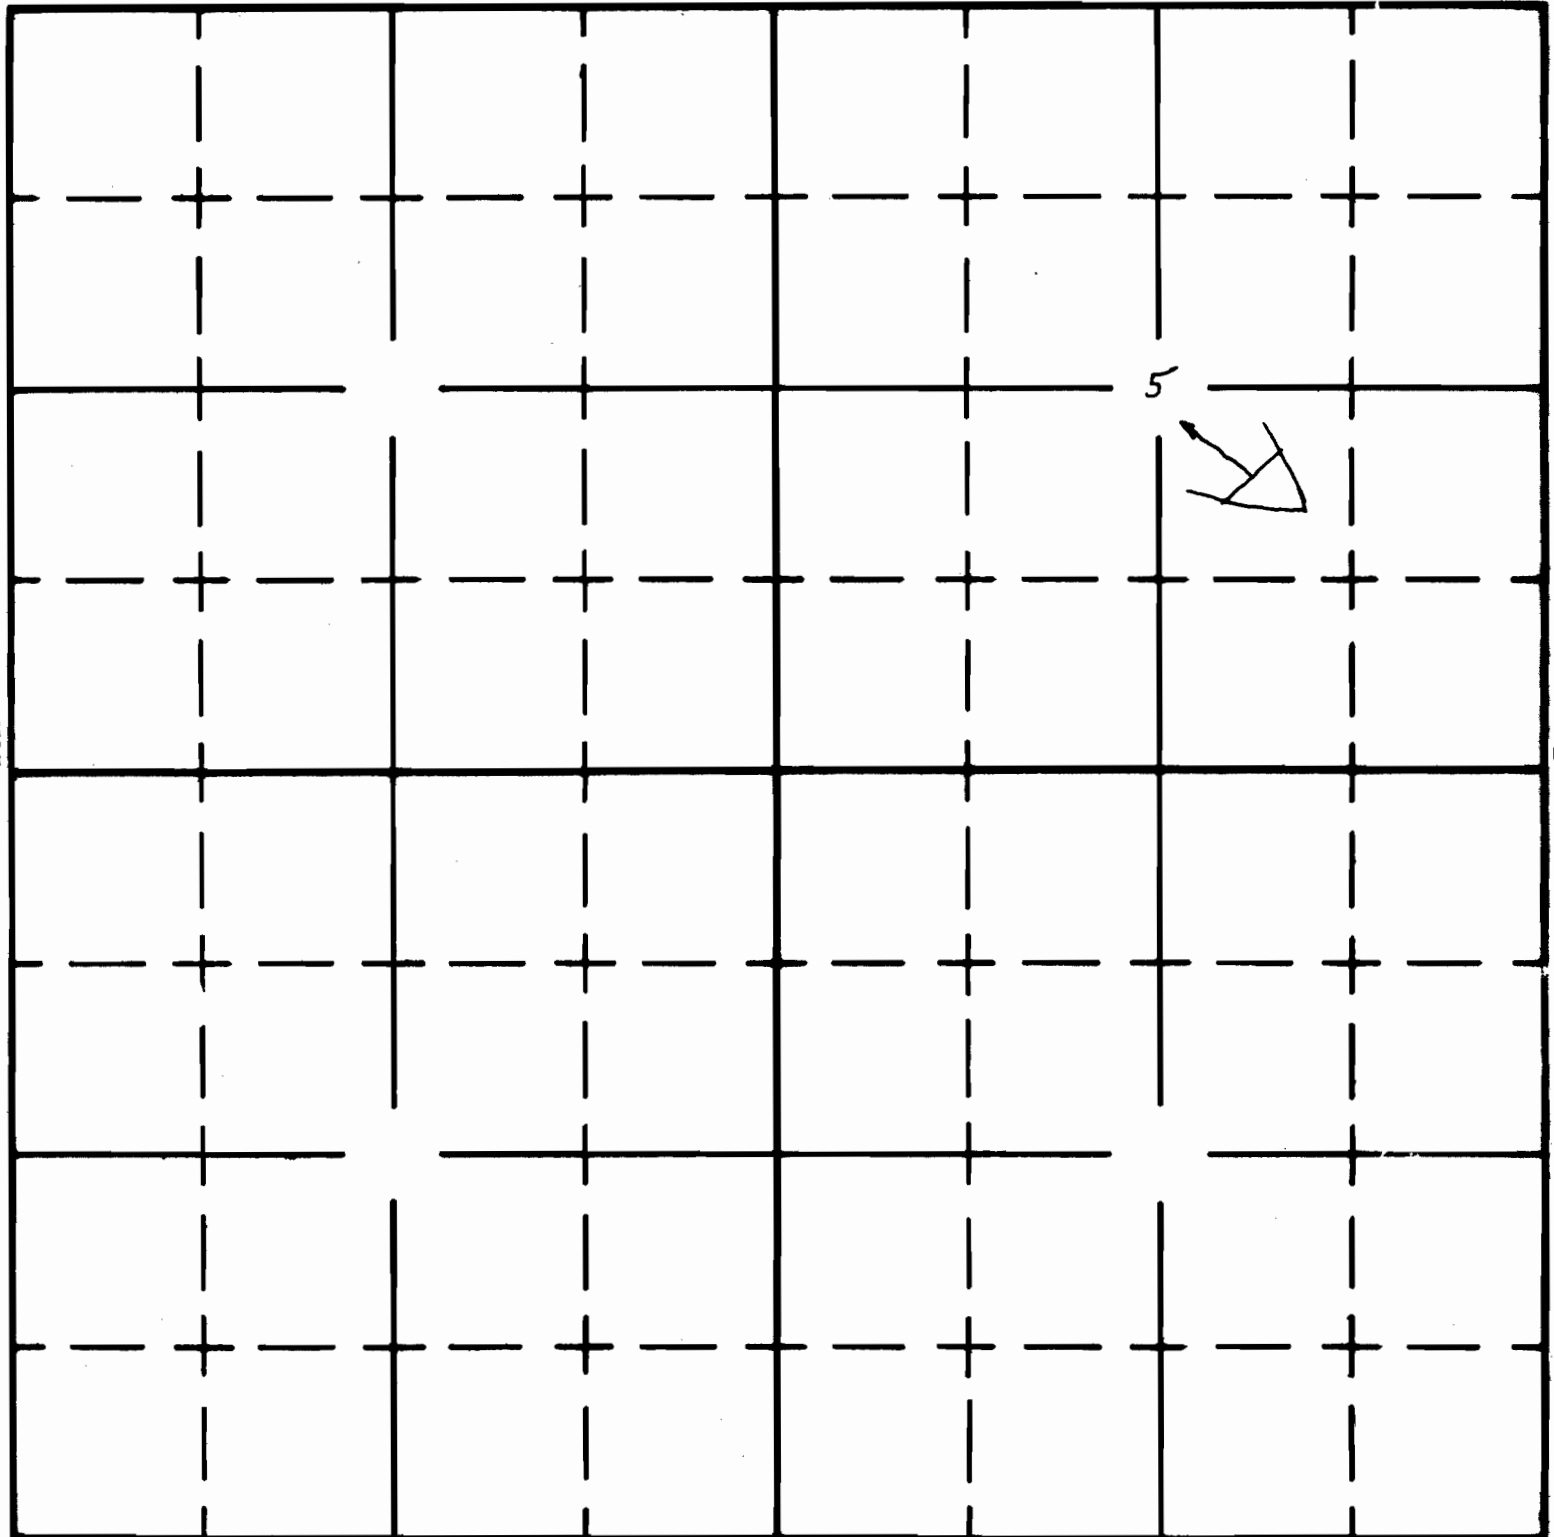

South

APPLICATION No. *R-36832*
PERMIT No. *R-3463*