Form A1-187
March 1961


UNITED STATES
DEPARTMENT OF THE INTERIOR
BUREAU OF LAND MANAGEMENT

SECTION
13

# Oregon State Water Filings

TOWNSHIP 23S, RANGE 38E, W. M.


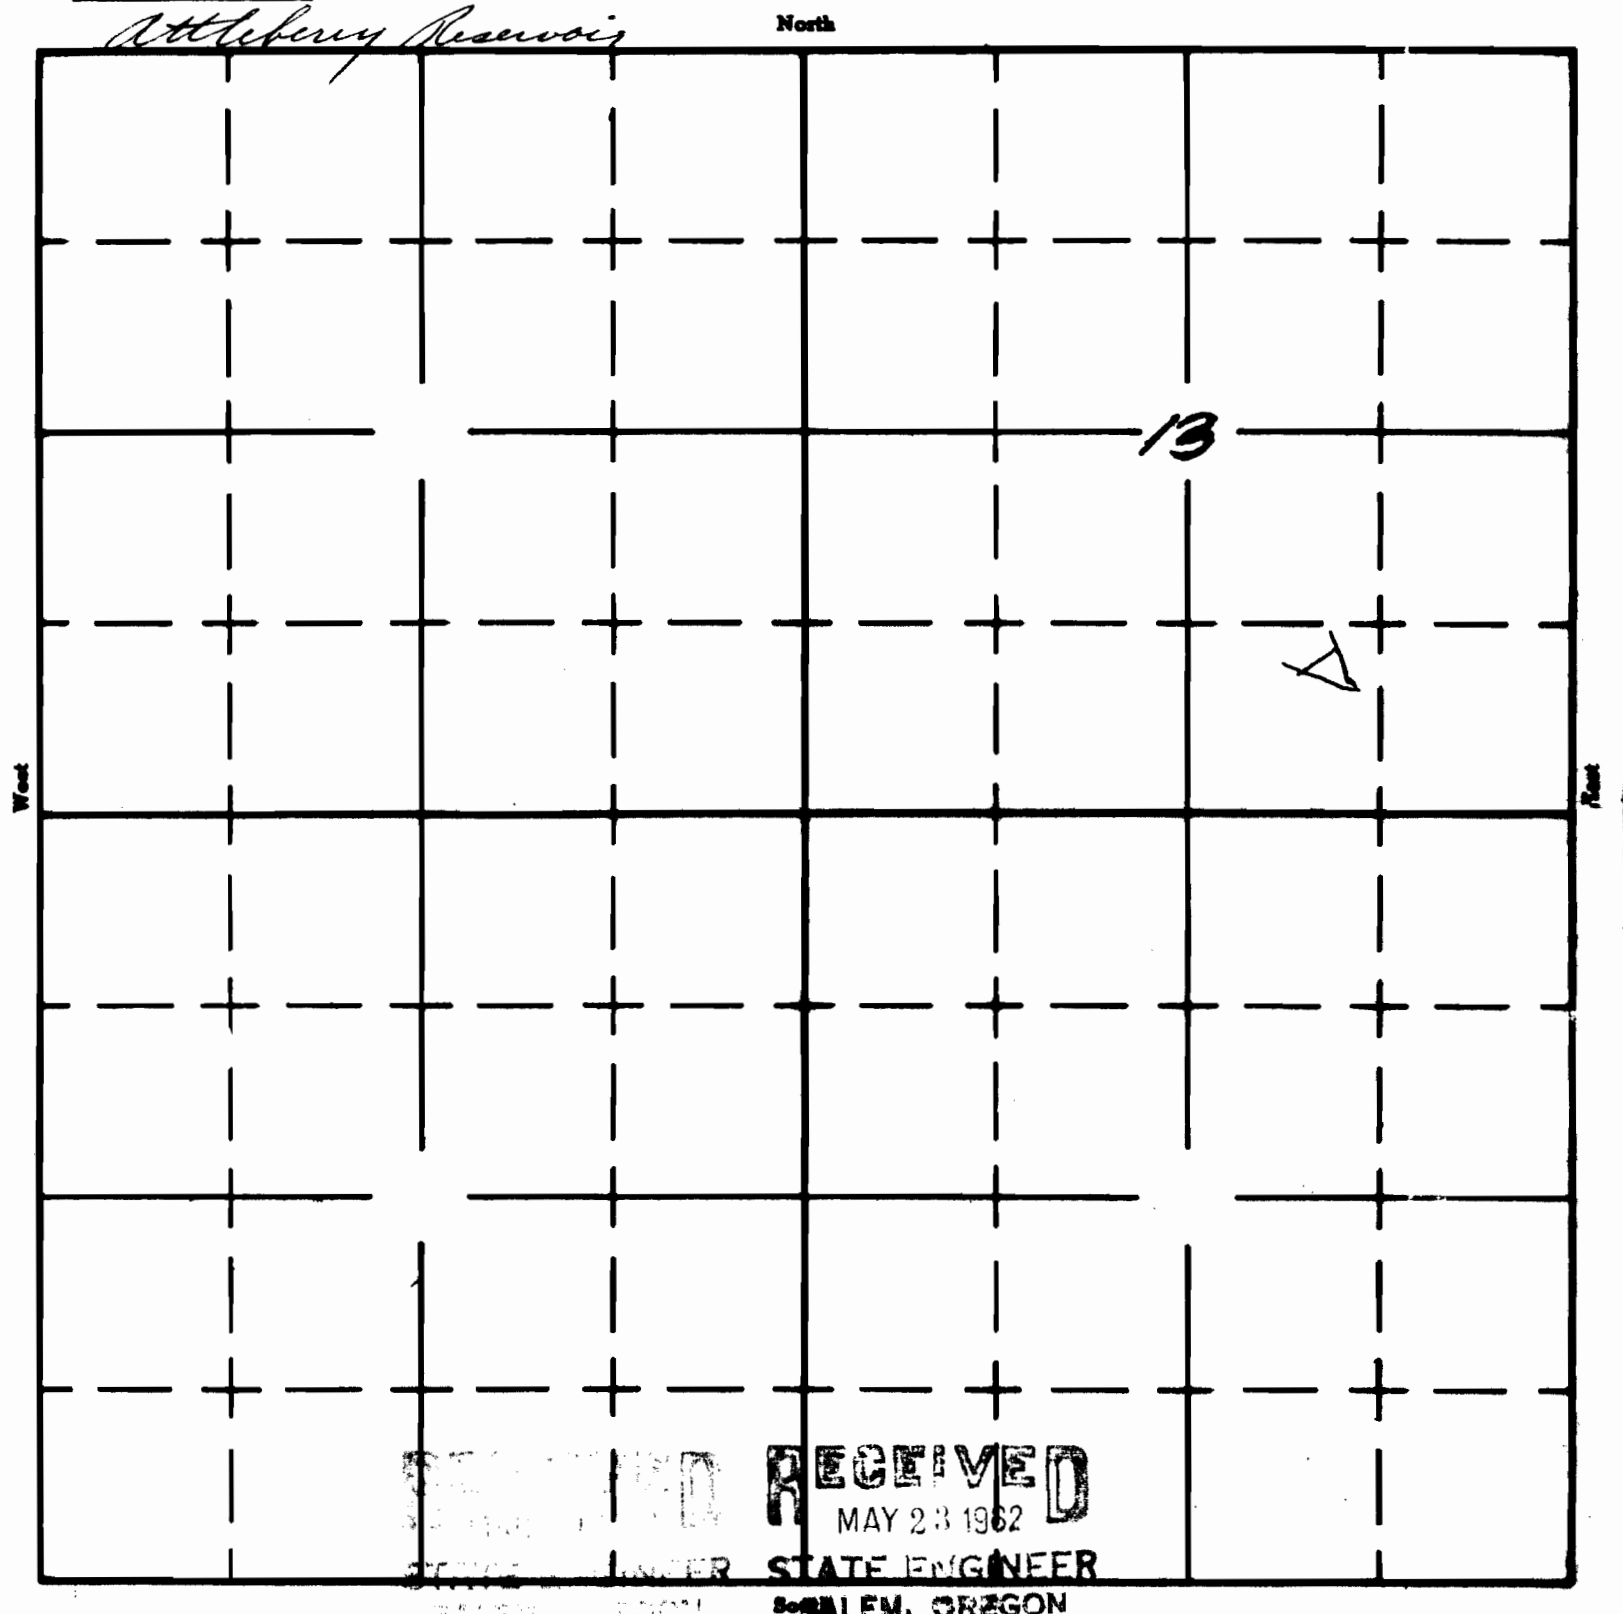


RECEIVED
MAY 23 1962
STATE ENGINEER
SALEM, OREGON

APPLICATION No. R-36842
PERMIT No. R-4340