


UNITED STATES
DEPARTMENT OF THE INTERIOR
BUREAU OF LAND MANAGEMENT

SECTION _____

Oregon State Water Filings

TOWNSHIP 17S., RANGE 45E., W. M.

Big Cat. RES
North

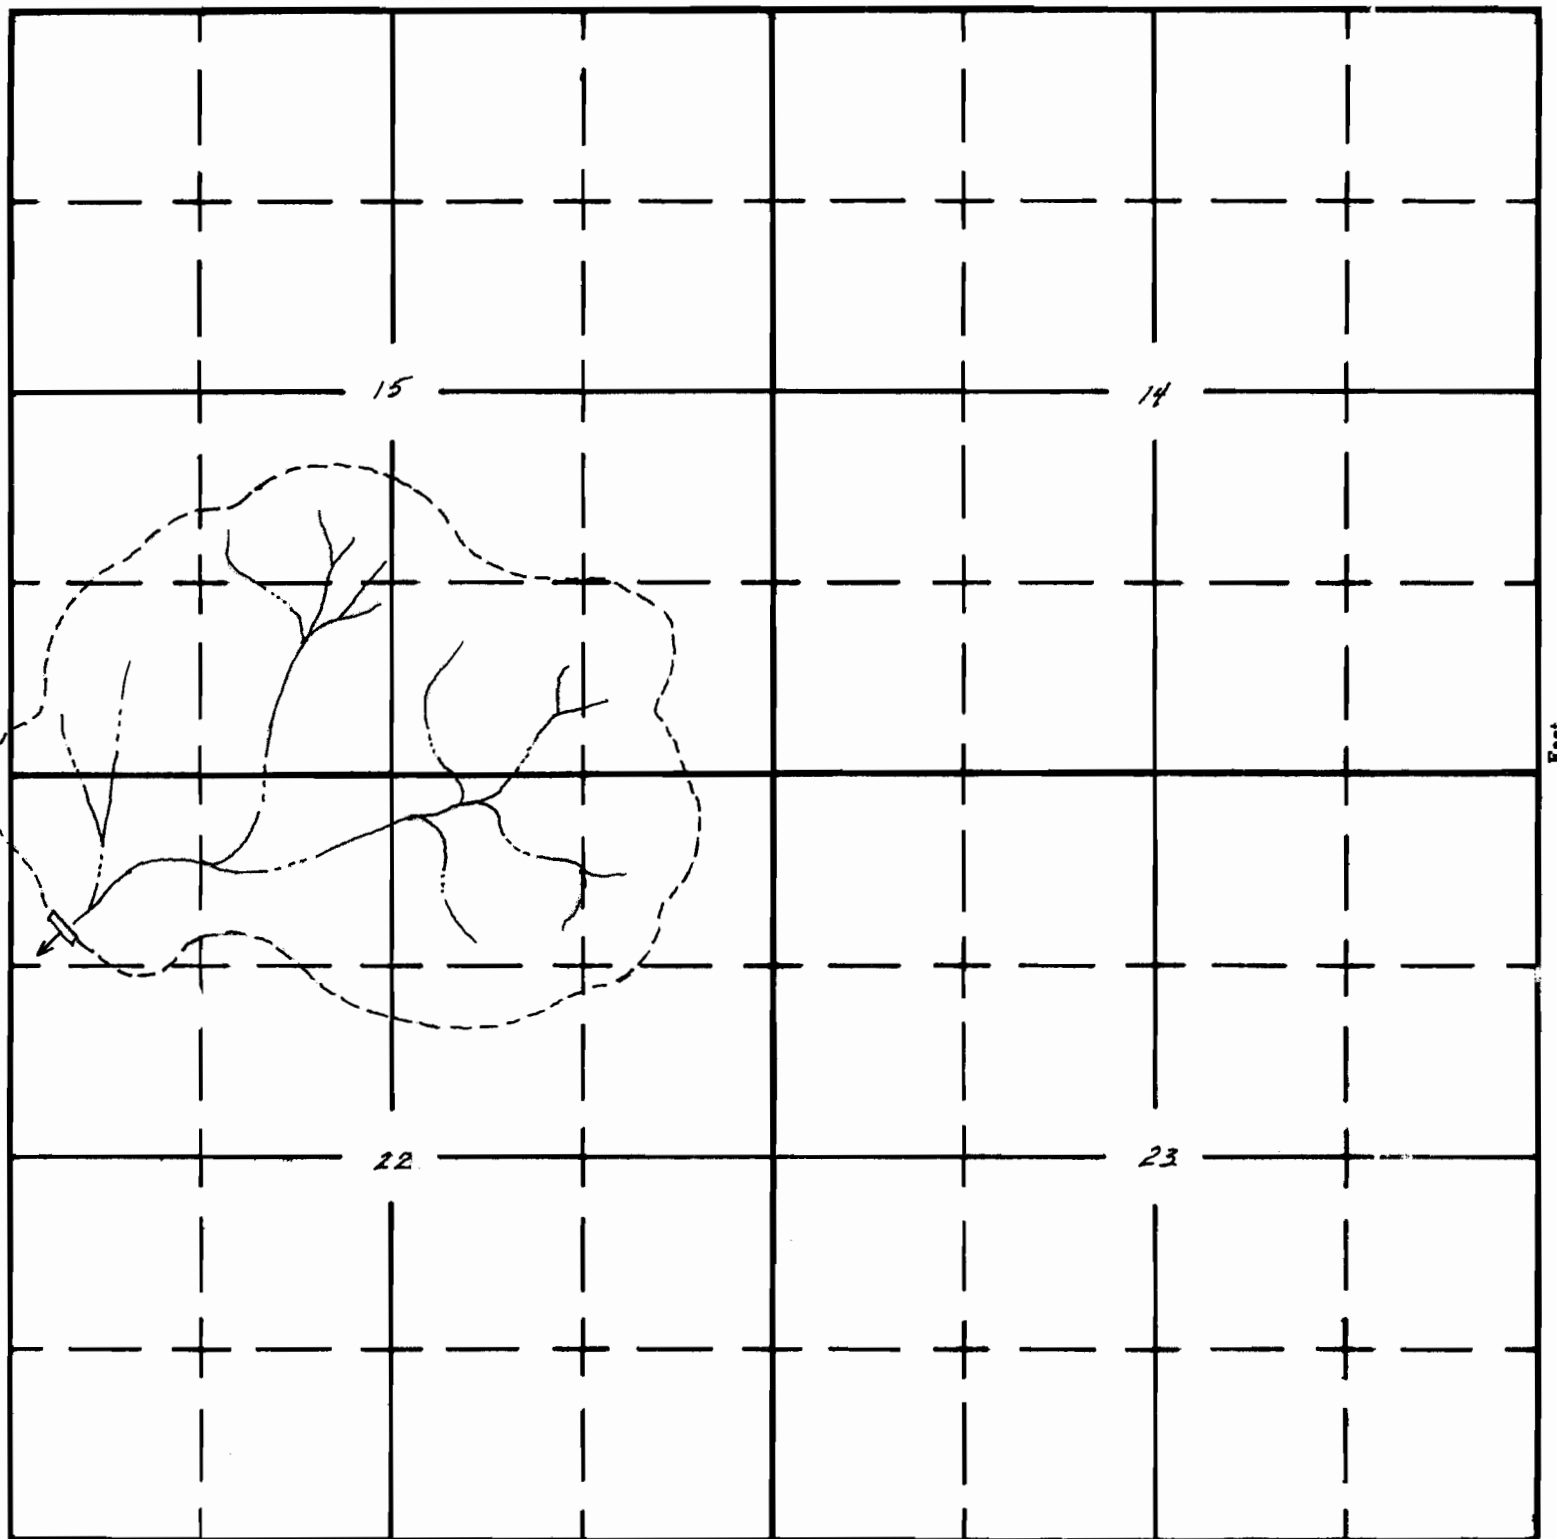

South

APPLICATION No. *R-40612*
PERMIT No. *R-5168*