


RECEIVED

APR 18 1994

WATER RESOURCES DEPT.
SALEM, OREGON

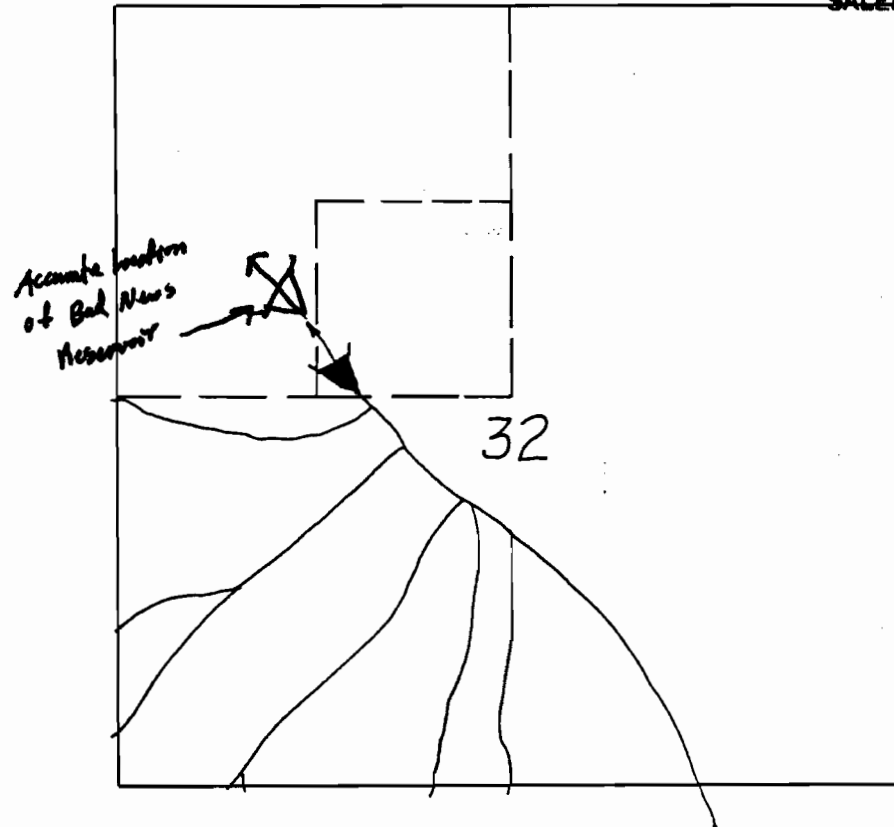

Application No. R-44756
Permit No. R 7293

RECEIVED
JUL 1 1968
STATE ENGINEER
SALEM, OREGON



U. S. DEPARTMENT OF THE INTERIOR
BUREAU OF LAND MANAGEMENT

SW BAD NEWS RES.
SE NW 4 SEC 32 T35S R40E
W. M.

DESIGNED _____	RECOMM. _____
DRAWN <u>RLM</u>	RECOMM. _____
CHECKED _____	APPROVED <u>[Signature]</u> CHIEF, DIV. OF EXC.

SCALE 4"=1mi

DATE June 5, 68

SHEET 1 OF 1

DRAWING NO.