


RECEIVED

APR 18 1994

WATER RESOURCES
SALEM, OREGON

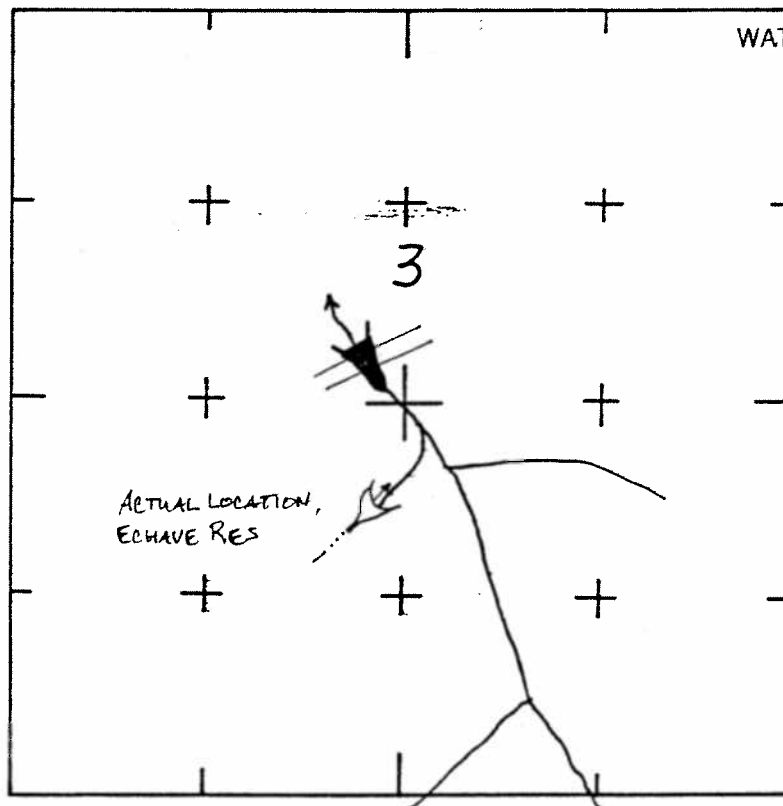

R. 44801

R 7335

RECEIVED
APR 18 1994
STATE ENGINEER
SALEM OREGON

U. S. DEPARTMENT OF THE INTERIOR
BUREAU OF LAND MANAGEMENT

ECHAVE RES.

SE 1/4 NW 1/4 SEC 3 T35S R43E

W.M.

DESIGNED _____

RECOMM. _____

DRAWN *R.M.*

RECOMM. _____

CHECKED _____

APPROVED _____

CHIEF, DIV. OF ENG.

SCALE 4"=1mi

DATE June 10, 68

SHEET 1 OF 1