

Form AI-187
March 1961

UNITED STATES
DEPARTMENT OF THE INTERIOR
BUREAU OF LAND MANAGEMENT


SECTION 28

Oregon State Water Filings

TOWNSHIP 18S, RANGE 39E, W. M.

Upper Gregory Cr. Res

North

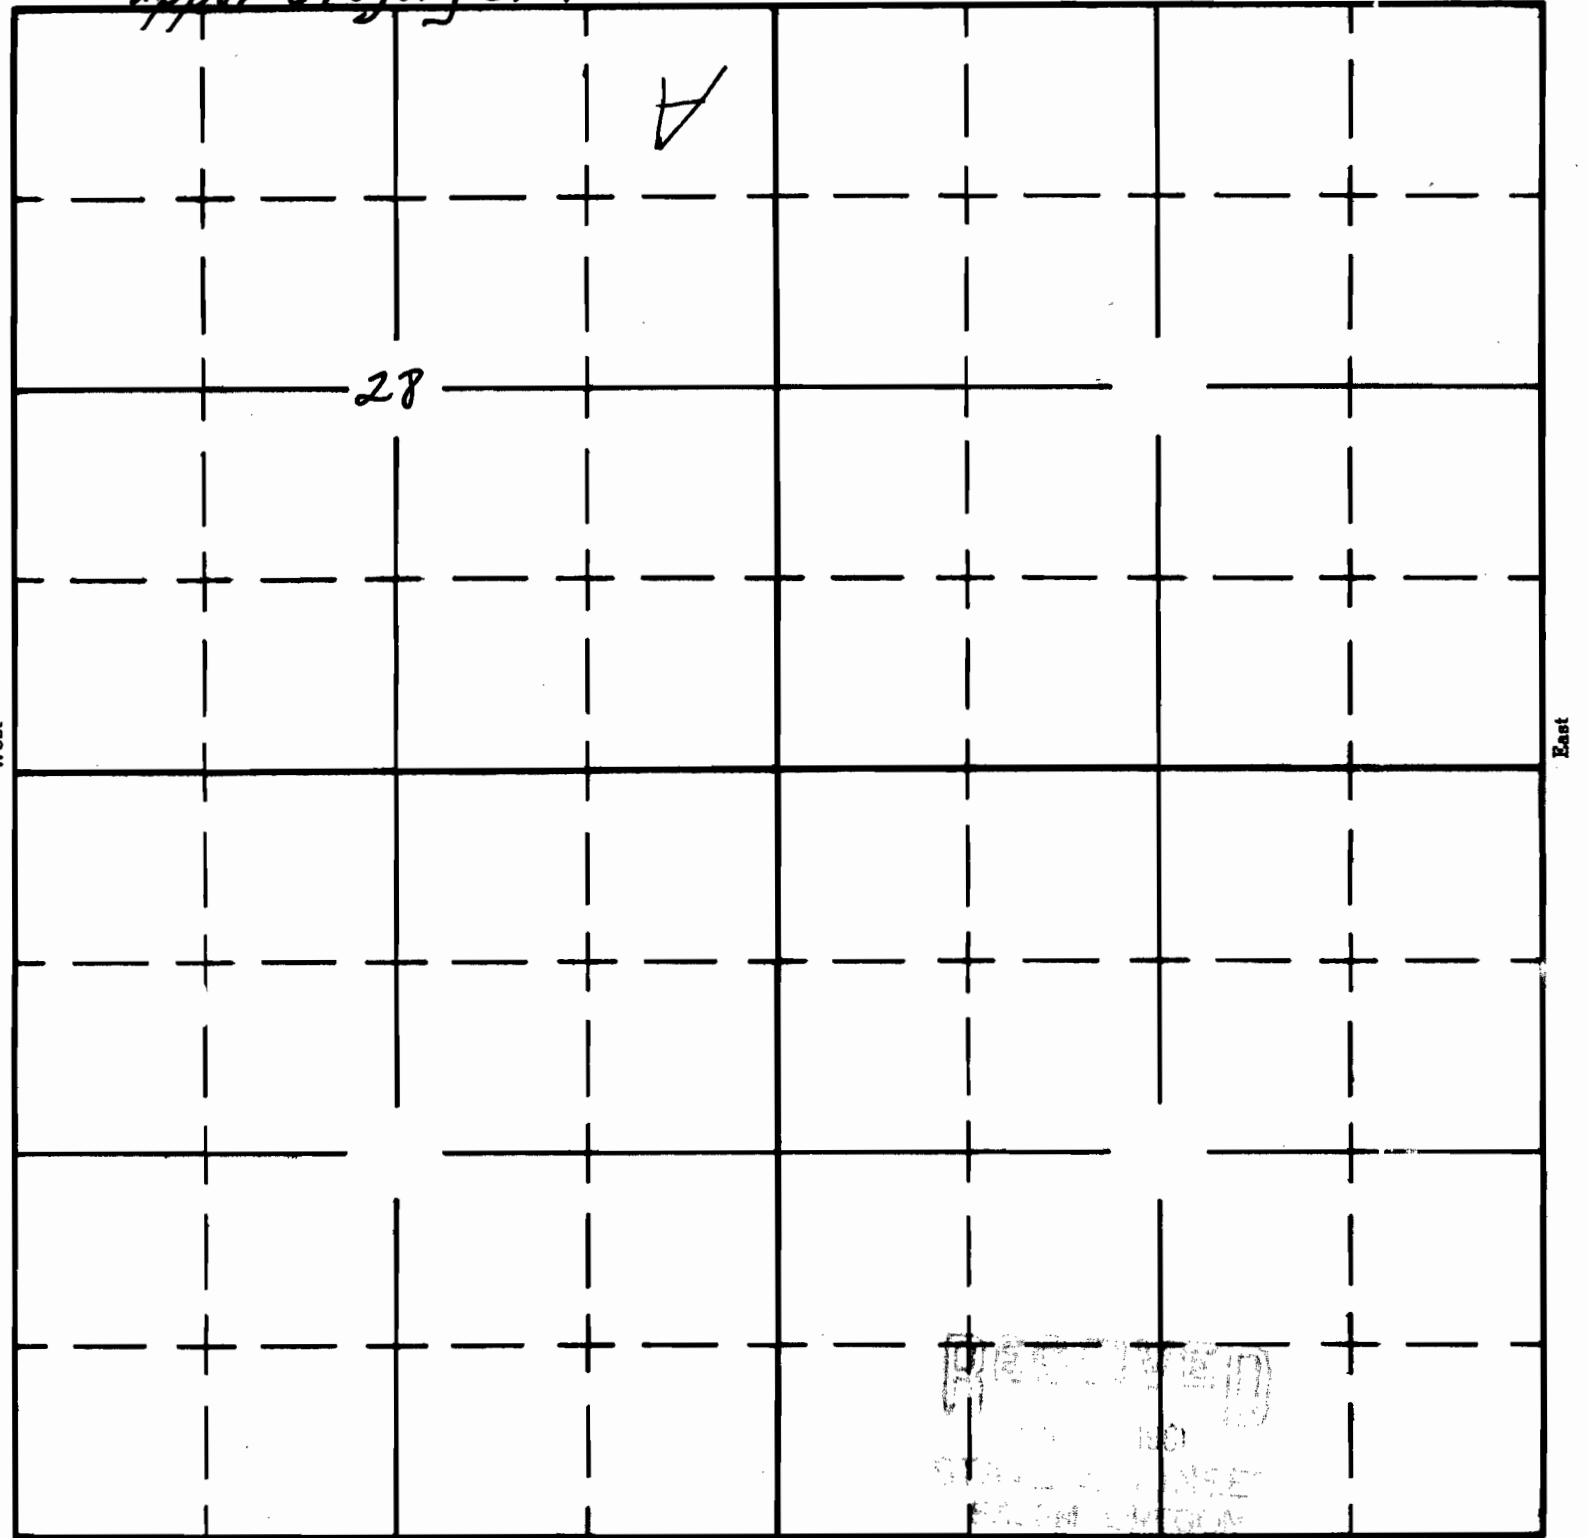

South

RECEIVED
NO
STATE OF OREGON
BUREAU OF LAND MANAGEMENT

APPLICATION No. R-36928
PERMIT No. **R 7920**