


UNITED STATES
DEPARTMENT OF THE INTERIOR
BUREAU OF LAND MANAGEMENT

revised
12/82
RECEIVED
MAR 18 1993

SECTION
Sec 13
SE 1/4 SW 1/4
NE 1/4 SW 1/4

Oregon State Water Filings

TOWNSHIP 22^S, RANGE 39^E, W. M.

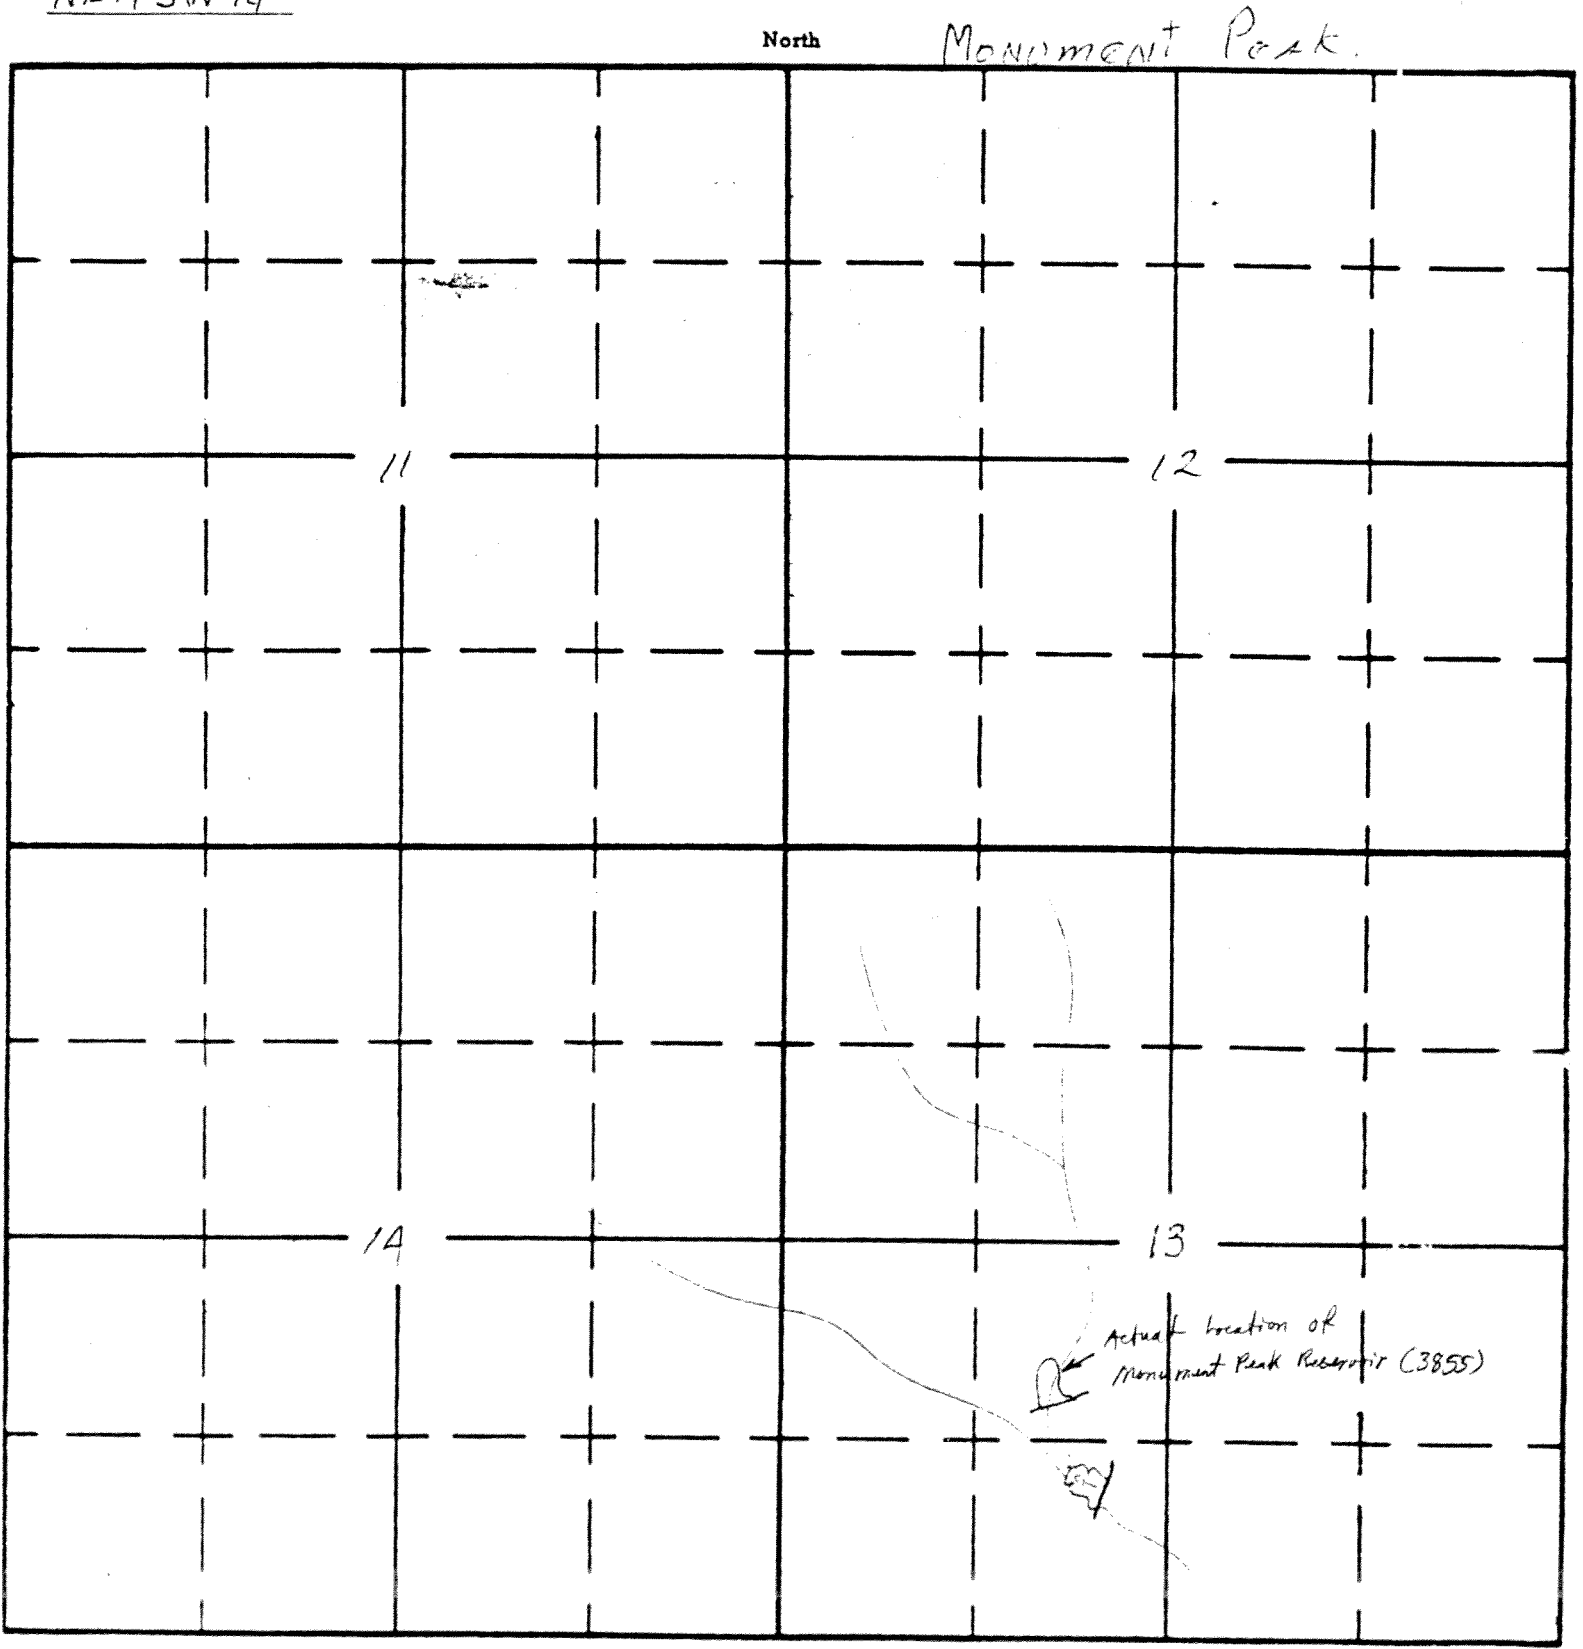

APP # R 45.500

APPLICATION No.