

Form A1-187
March 1961


UNITED STATES
DEPARTMENT OF THE INTERIOR
BUREAU OF LAND MANAGEMENT

SECTION
W⁴ NW⁴
Sec 10

Oregon State Water Filings

TOWNSHIP 22 S. RANGE 39 E., W. M.

North

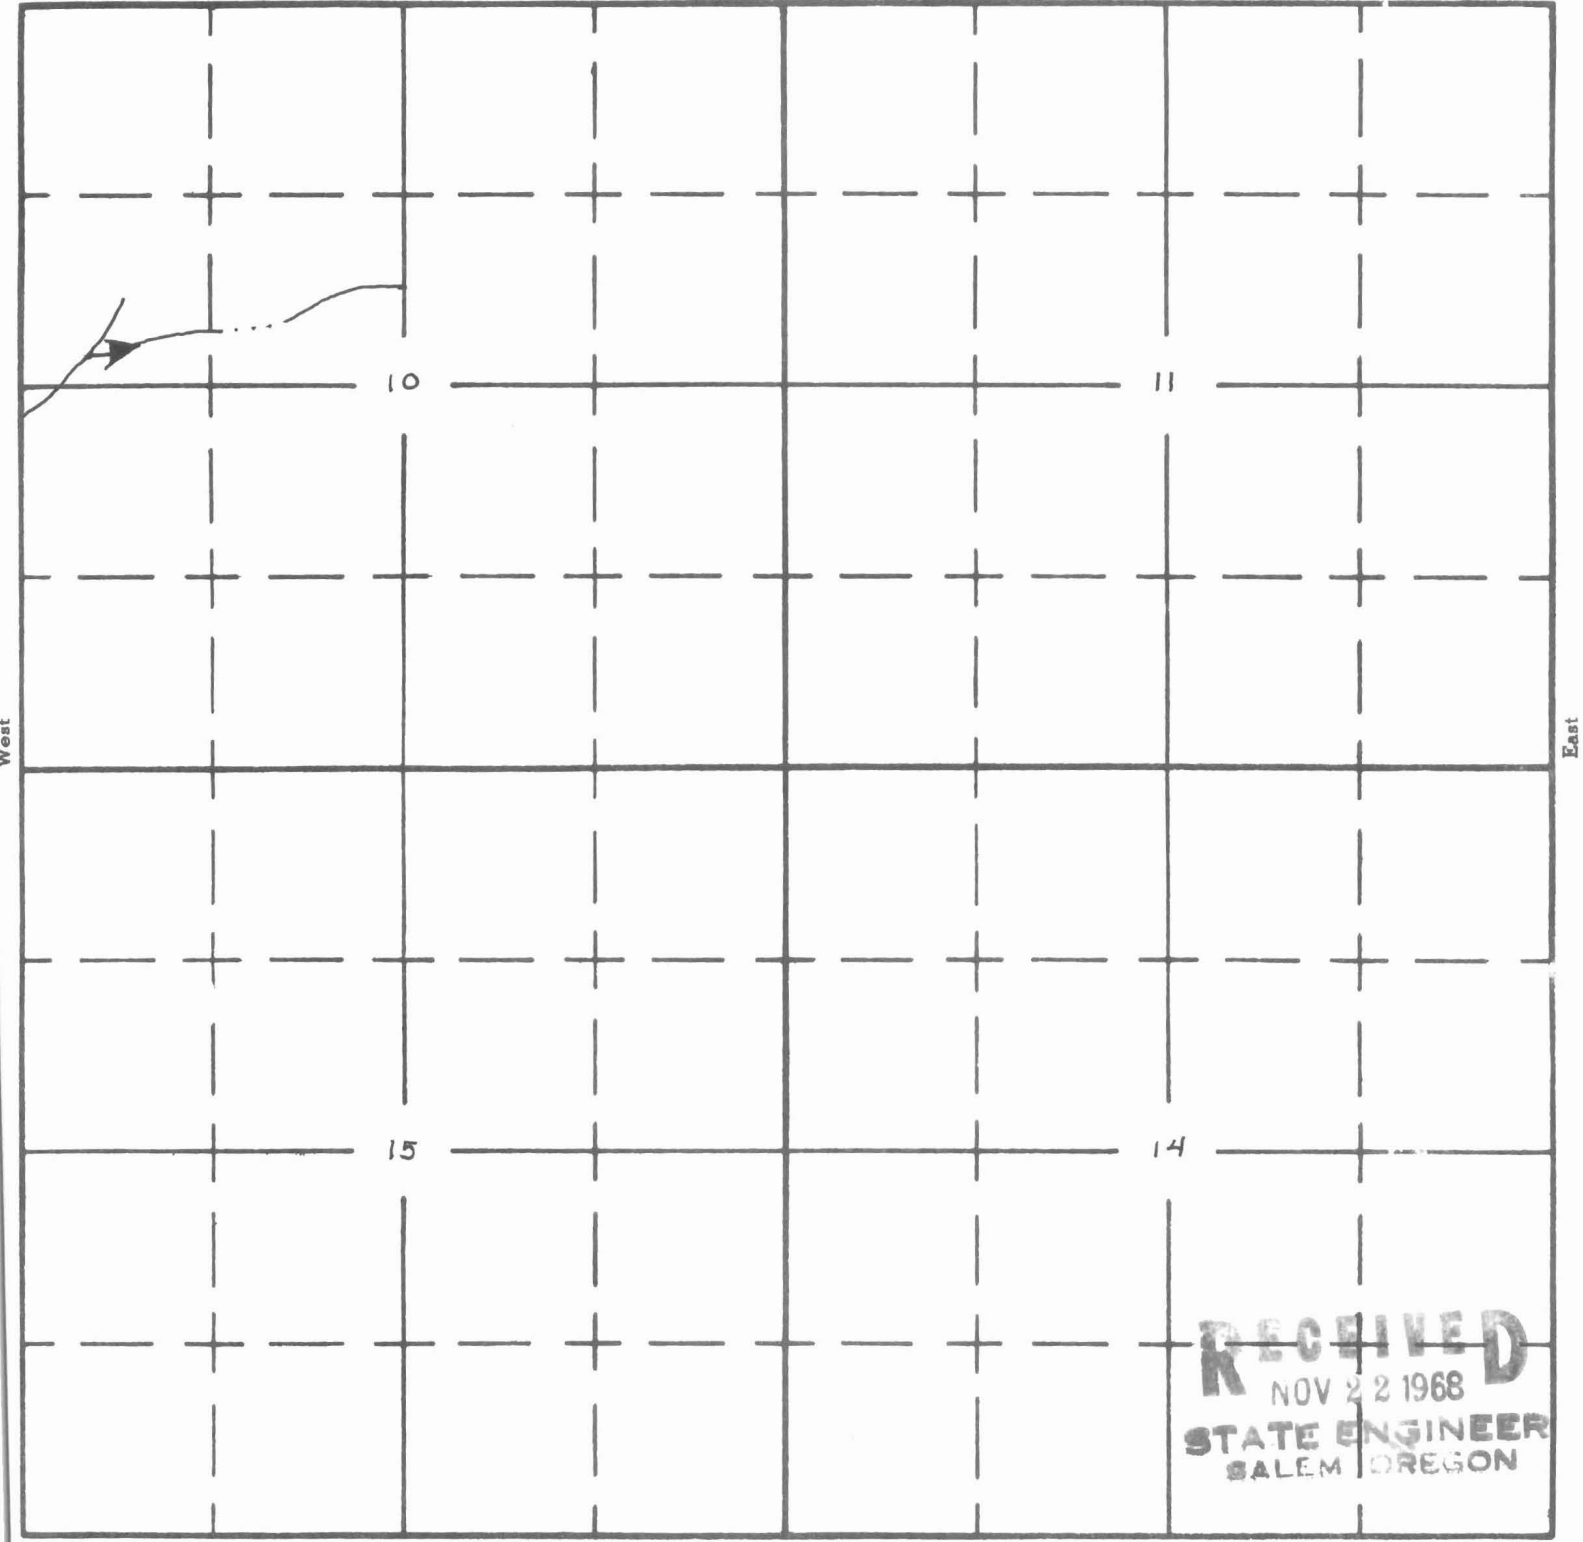

South

RECEIVED
NOV 22 1968
STATE ENGINEER
SALEM OREGON

APPLICATION No. _____
DEPARTMENT NO. 2400