


UNITED STATES  
DEPARTMENT OF THE INTERIOR  
BUREAU OF LAND MANAGEMENT

SECTION 2  
SW<sup>4</sup> NE<sup>4</sup>

# Oregon State Water Filings

TOWNSHIP 25 S, RANGE 40 E, W. M.

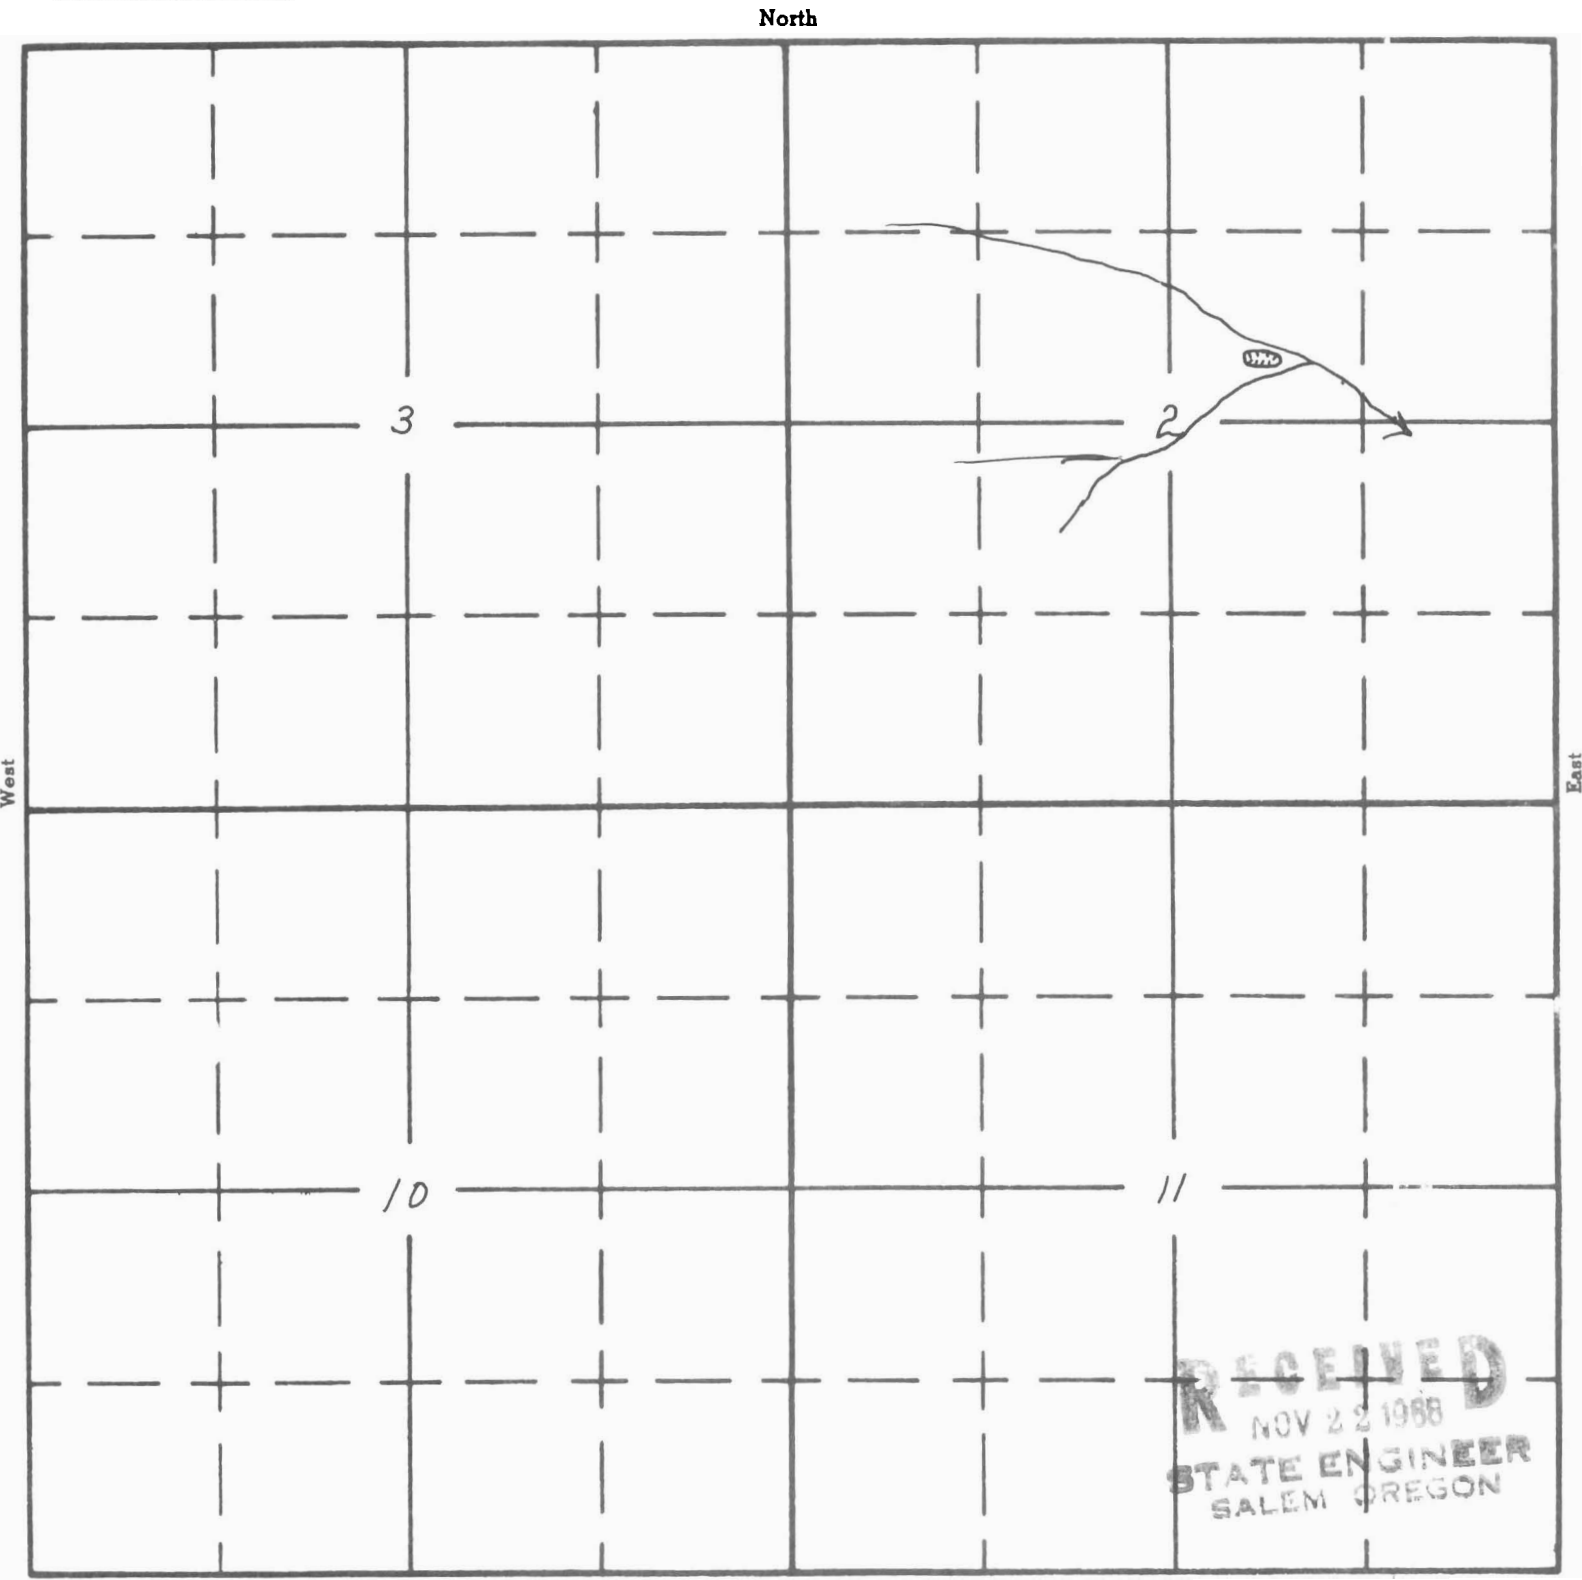

*Big Field Pit*

**RECEIVED**  
NOV 22 1968  
STATE ENGINEER  
SALEM OREGON

APPLICATION No. 7440  
PERMIT No.