

UNITED STATES
DEPARTMENT OF THE INTERIOR
BUREAU OF LAND MANAGEMENT

SECTION 23

Oregon State Water Filings


SADDLE BUTTE

SW $\frac{1}{4}$ NW $\frac{1}{4}$

TOWNSHIP 26 S, RANGE 45 E, W. M.

SCALE 8" = 1 MI.

North

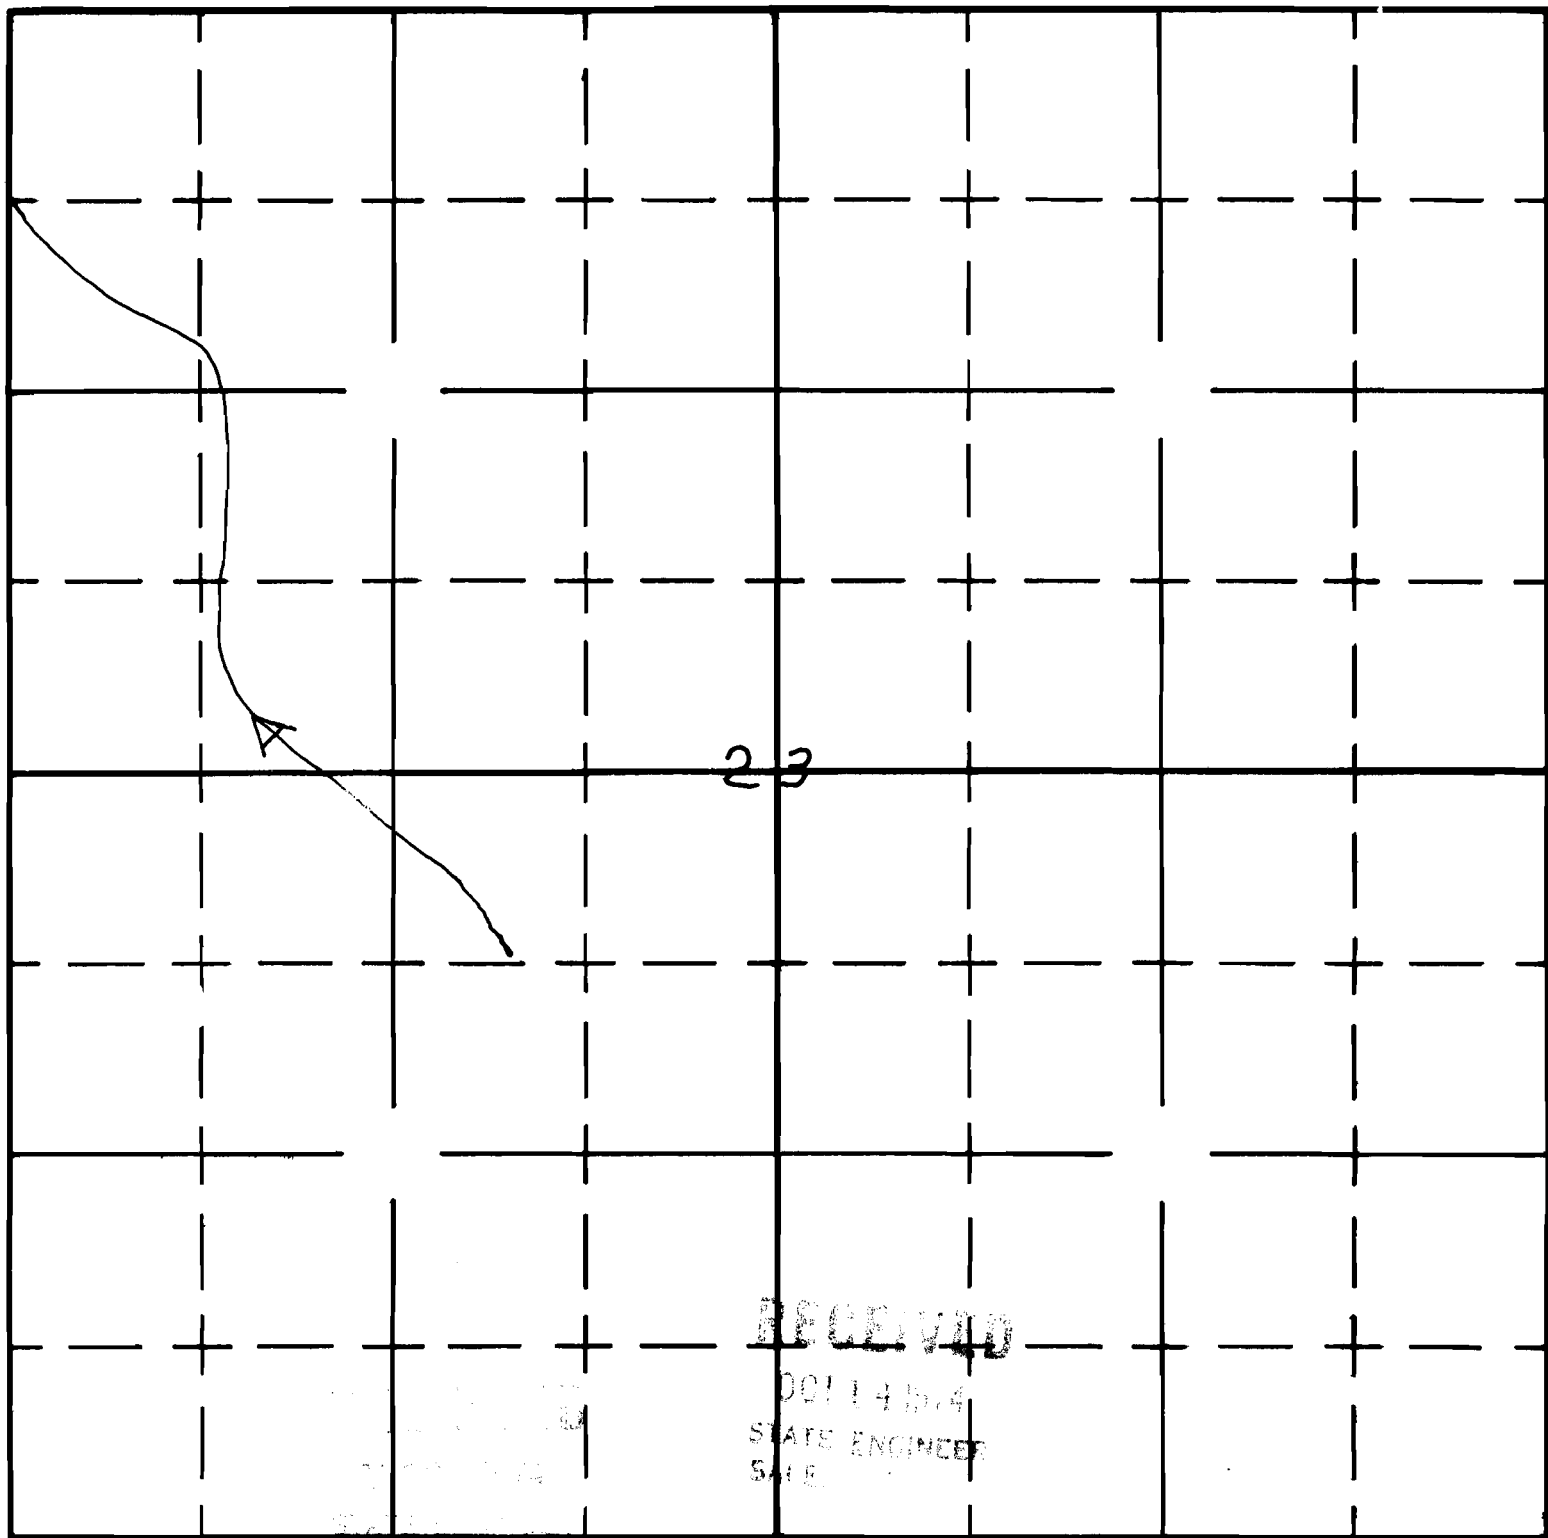

South

APPLICATION No. R-52288
PERMIT No. 7504