

UNITED STATES
DEPARTMENT OF THE INTERIOR
BUREAU OF LAND MANAGEMENT


SECTION 26

Oregon State Water Filings

NW $\frac{1}{4}$ NE $\frac{1}{4}$ TOWNSHIP 40 S, RANGE 40 E, W. M.

SCALE 8" = 1 MI.

North

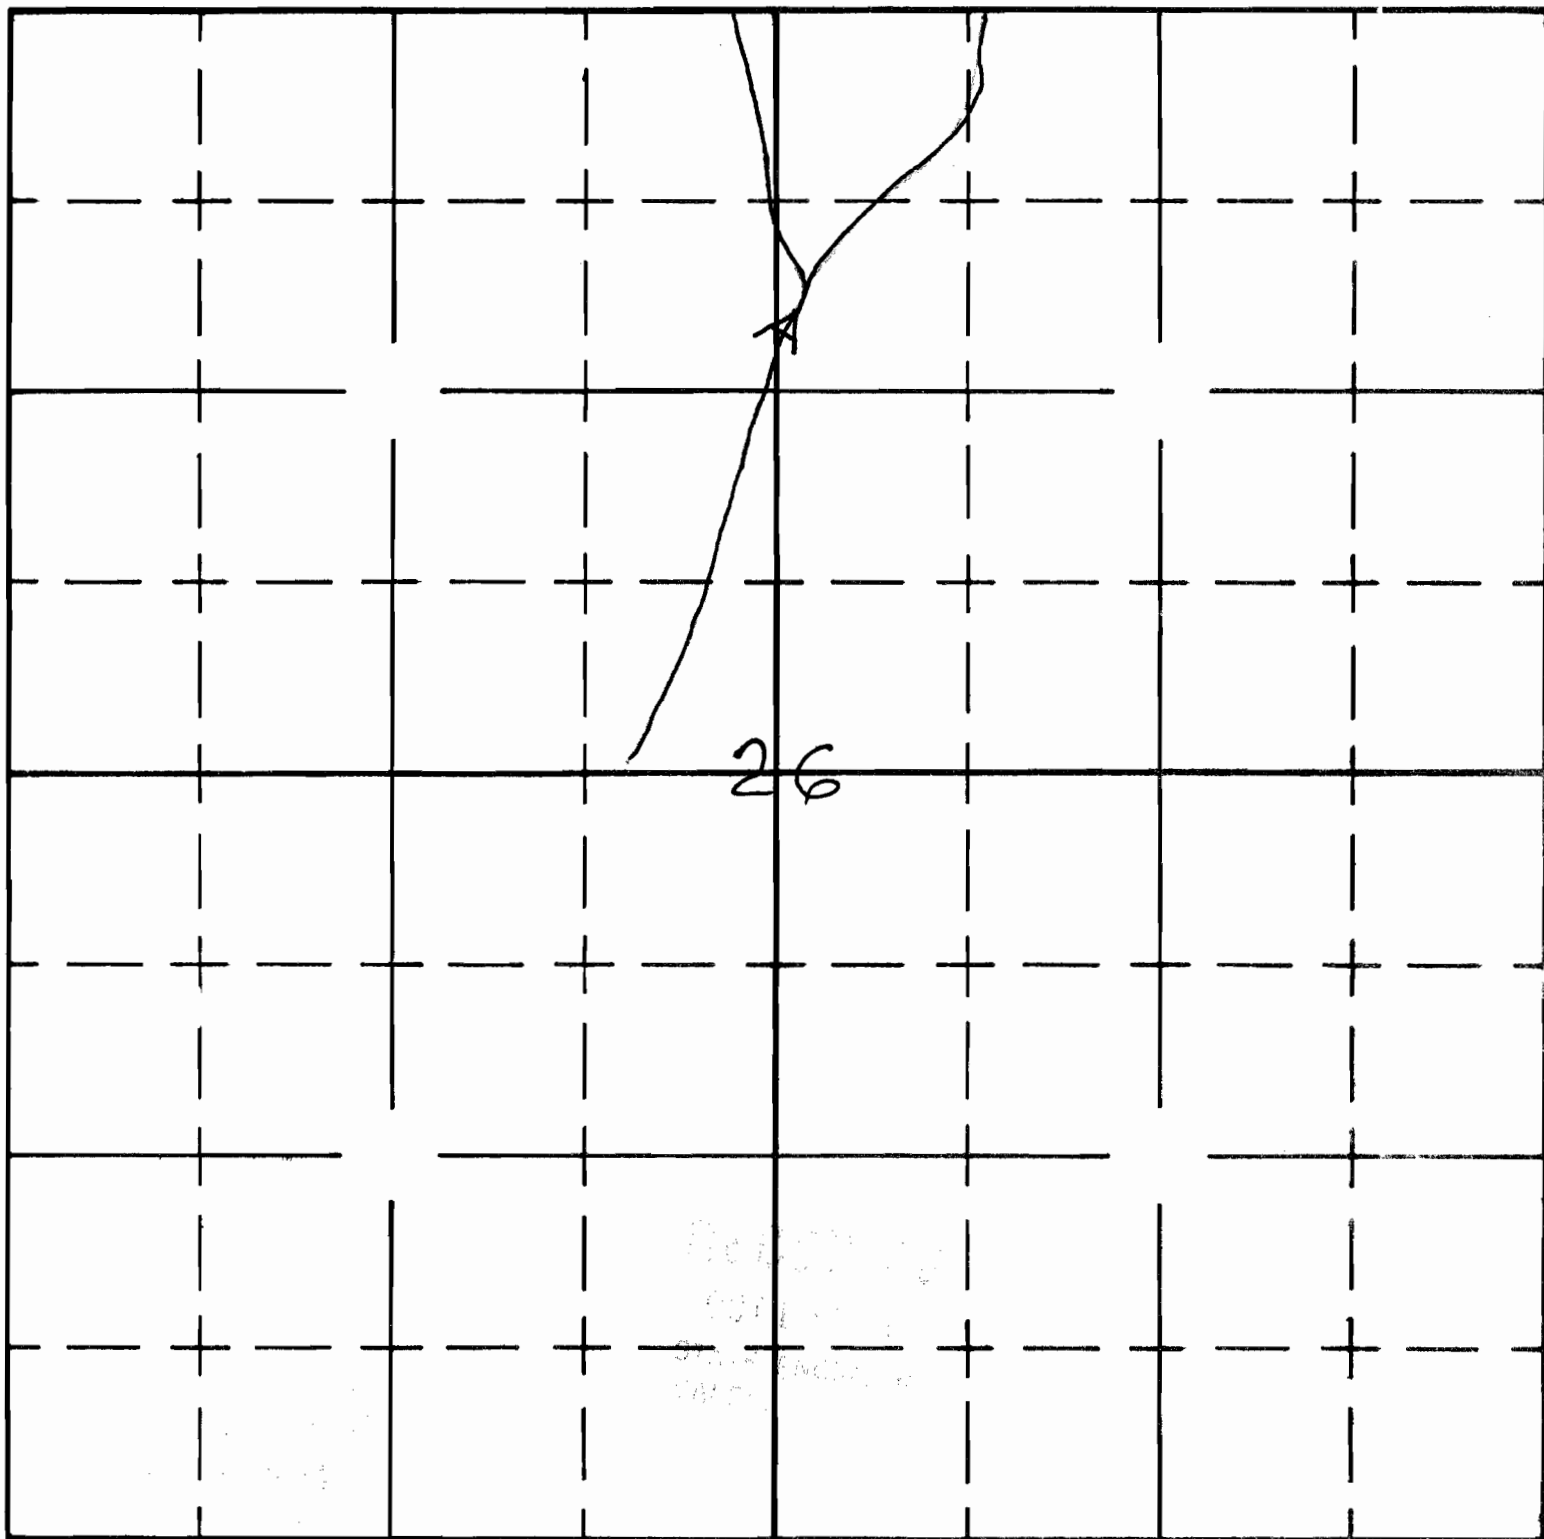

South

APPLICATION No. R-52292
PERMIT No. R 7507