

UNITED STATES
DEPARTMENT OF THE INTERIOR
BUREAU OF LAND MANAGEMENT

SECTION

Oregon State Water Filings

22
N.W. N.W.

TOWNSHIP 17^S, RANGE 39^E, W. M.

North

SCOTT

Application No. R-63564
Permit No. R 9297

16

15

21

22

RECEIVED

MAY 24 1962

WATER RESOURCES DEPT
SALEM, OREGON

APPLICATION No.
PERMIT No.

187
1961

UNITED STATES
DEPARTMENT OF THE INTERIOR
BUREAU OF LAND MANAGEMENT


SECTION

15

SW $\frac{1}{4}$ of SW $\frac{1}{4}$

Oregon State Water Filings

TOWNSHIP 17S, RANGE 39E, W. M.

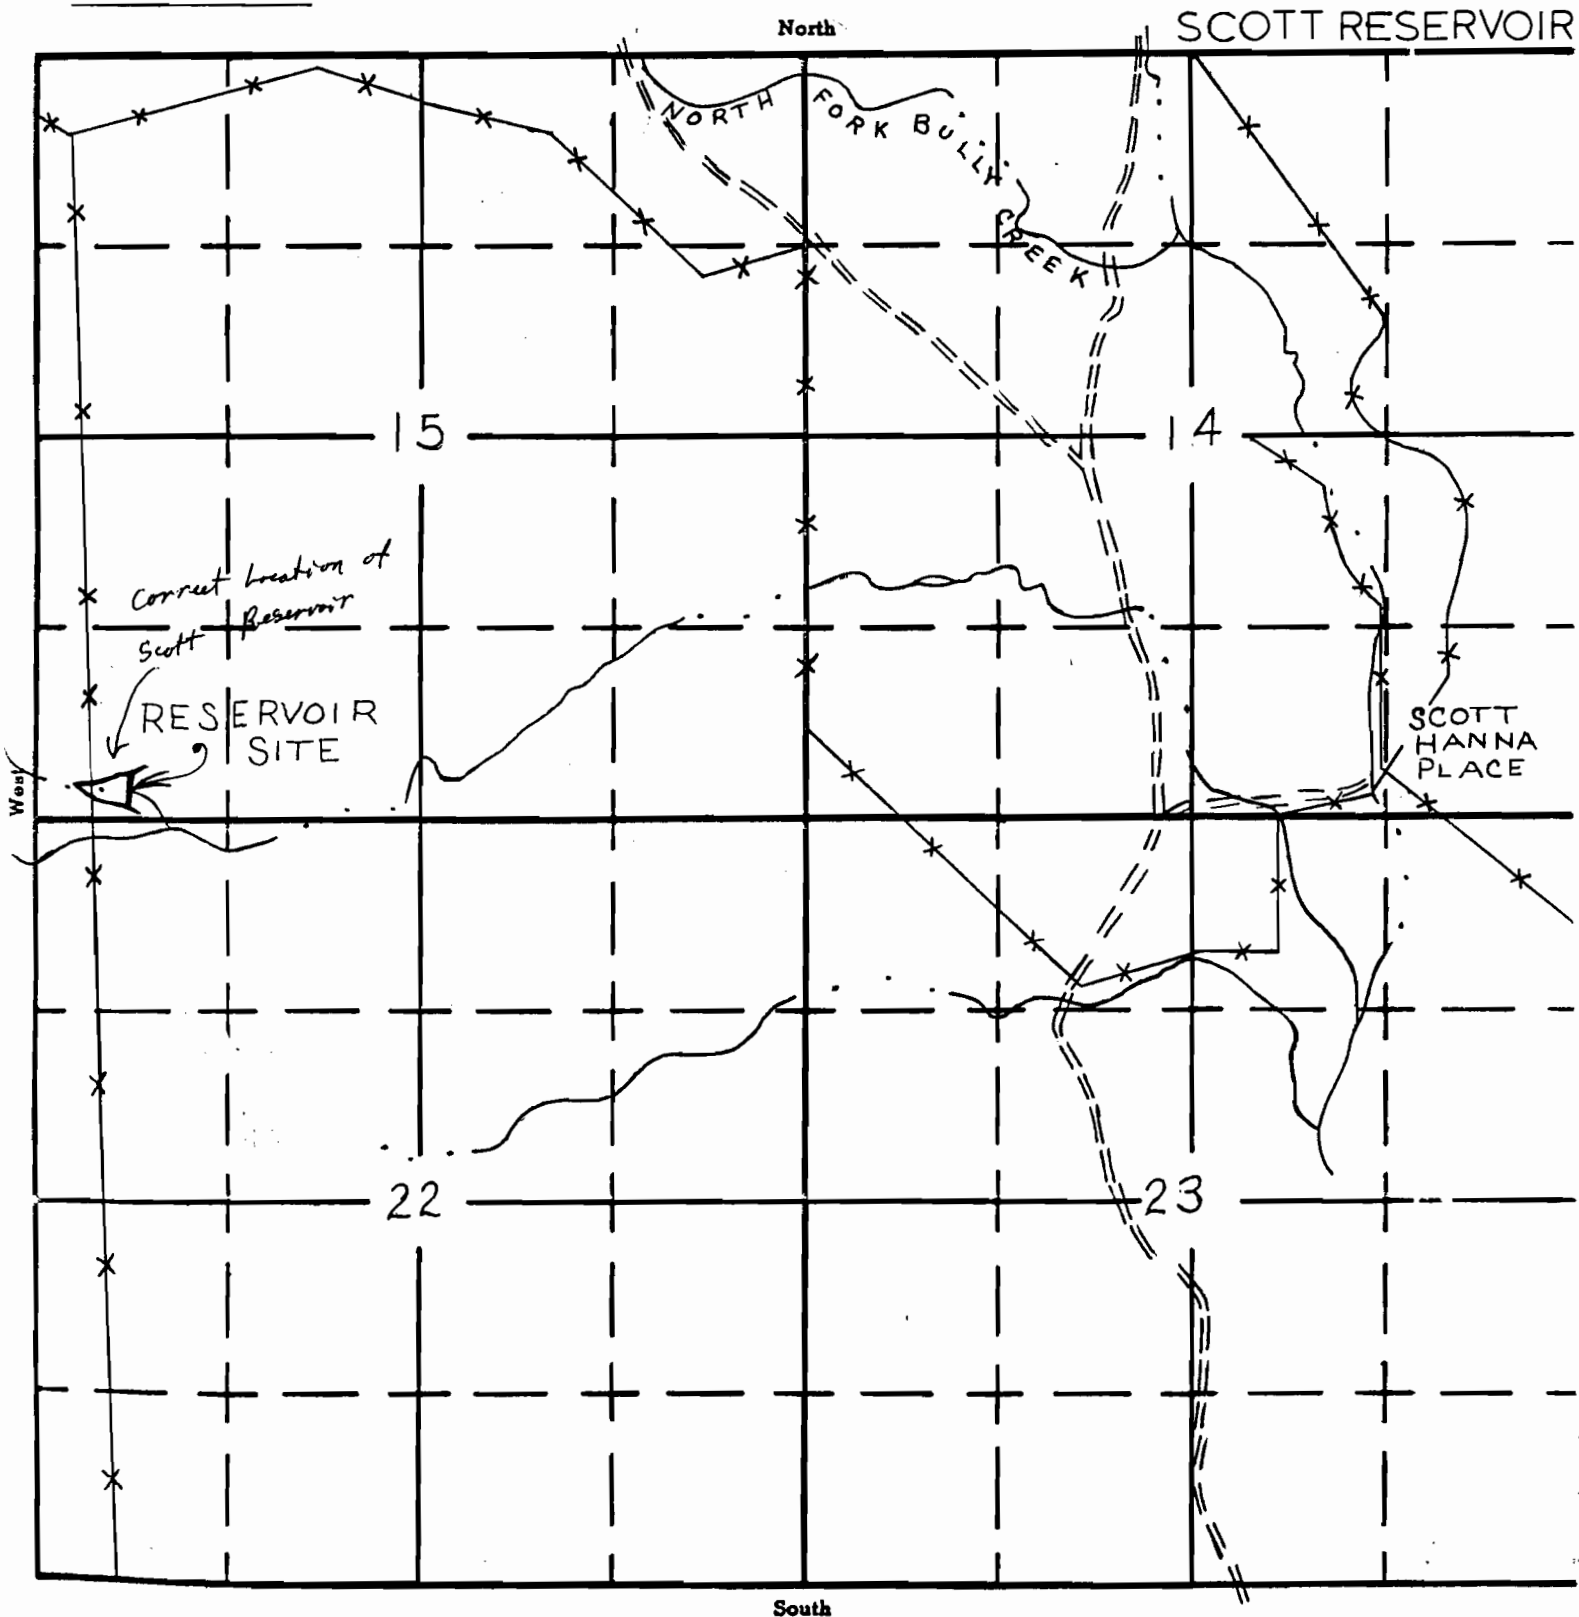

APPLICATION N1067C

DEDA/ST N.