

-187
1961

UNITED STATES
DEPARTMENT OF THE INTERIOR
BUREAU OF LAND MANAGEMENT

RECEIVED
MAR 18 1961

SECTION


Oregon State Water Filings

TOWNSHIP 17^S, RANGE 43^E, W. M.

7
N.E. SW

North

MORRISON DIVERSION

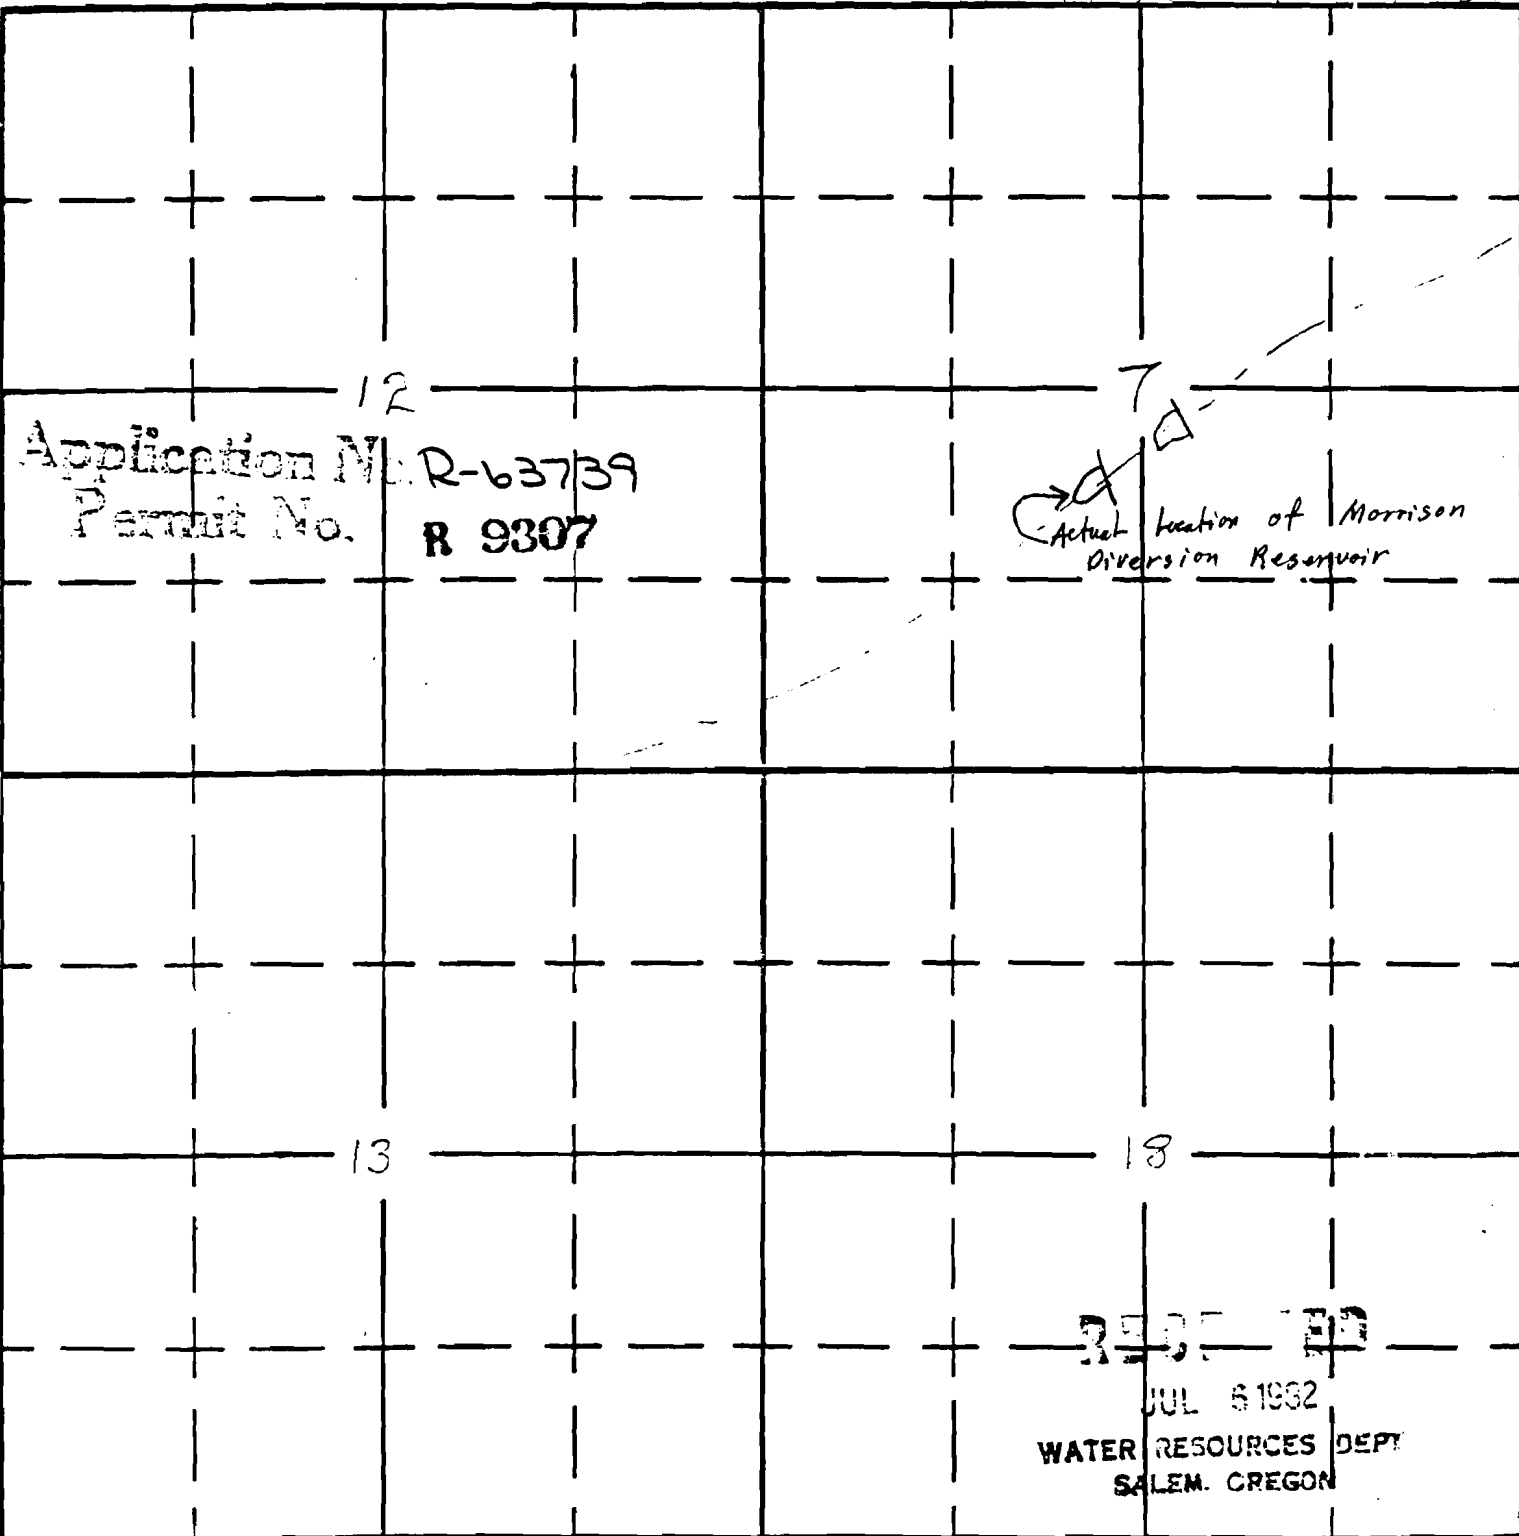

Application No. R-63739
Permit No. R 9307

Actual location of Morrison
Diversion Reservoir

RECEIVED
JUL 6 1962
WATER RESOURCES DEPT
SALEM, OREGON

South

APPLICATION No.
DEPT. OF THE INTERIOR