


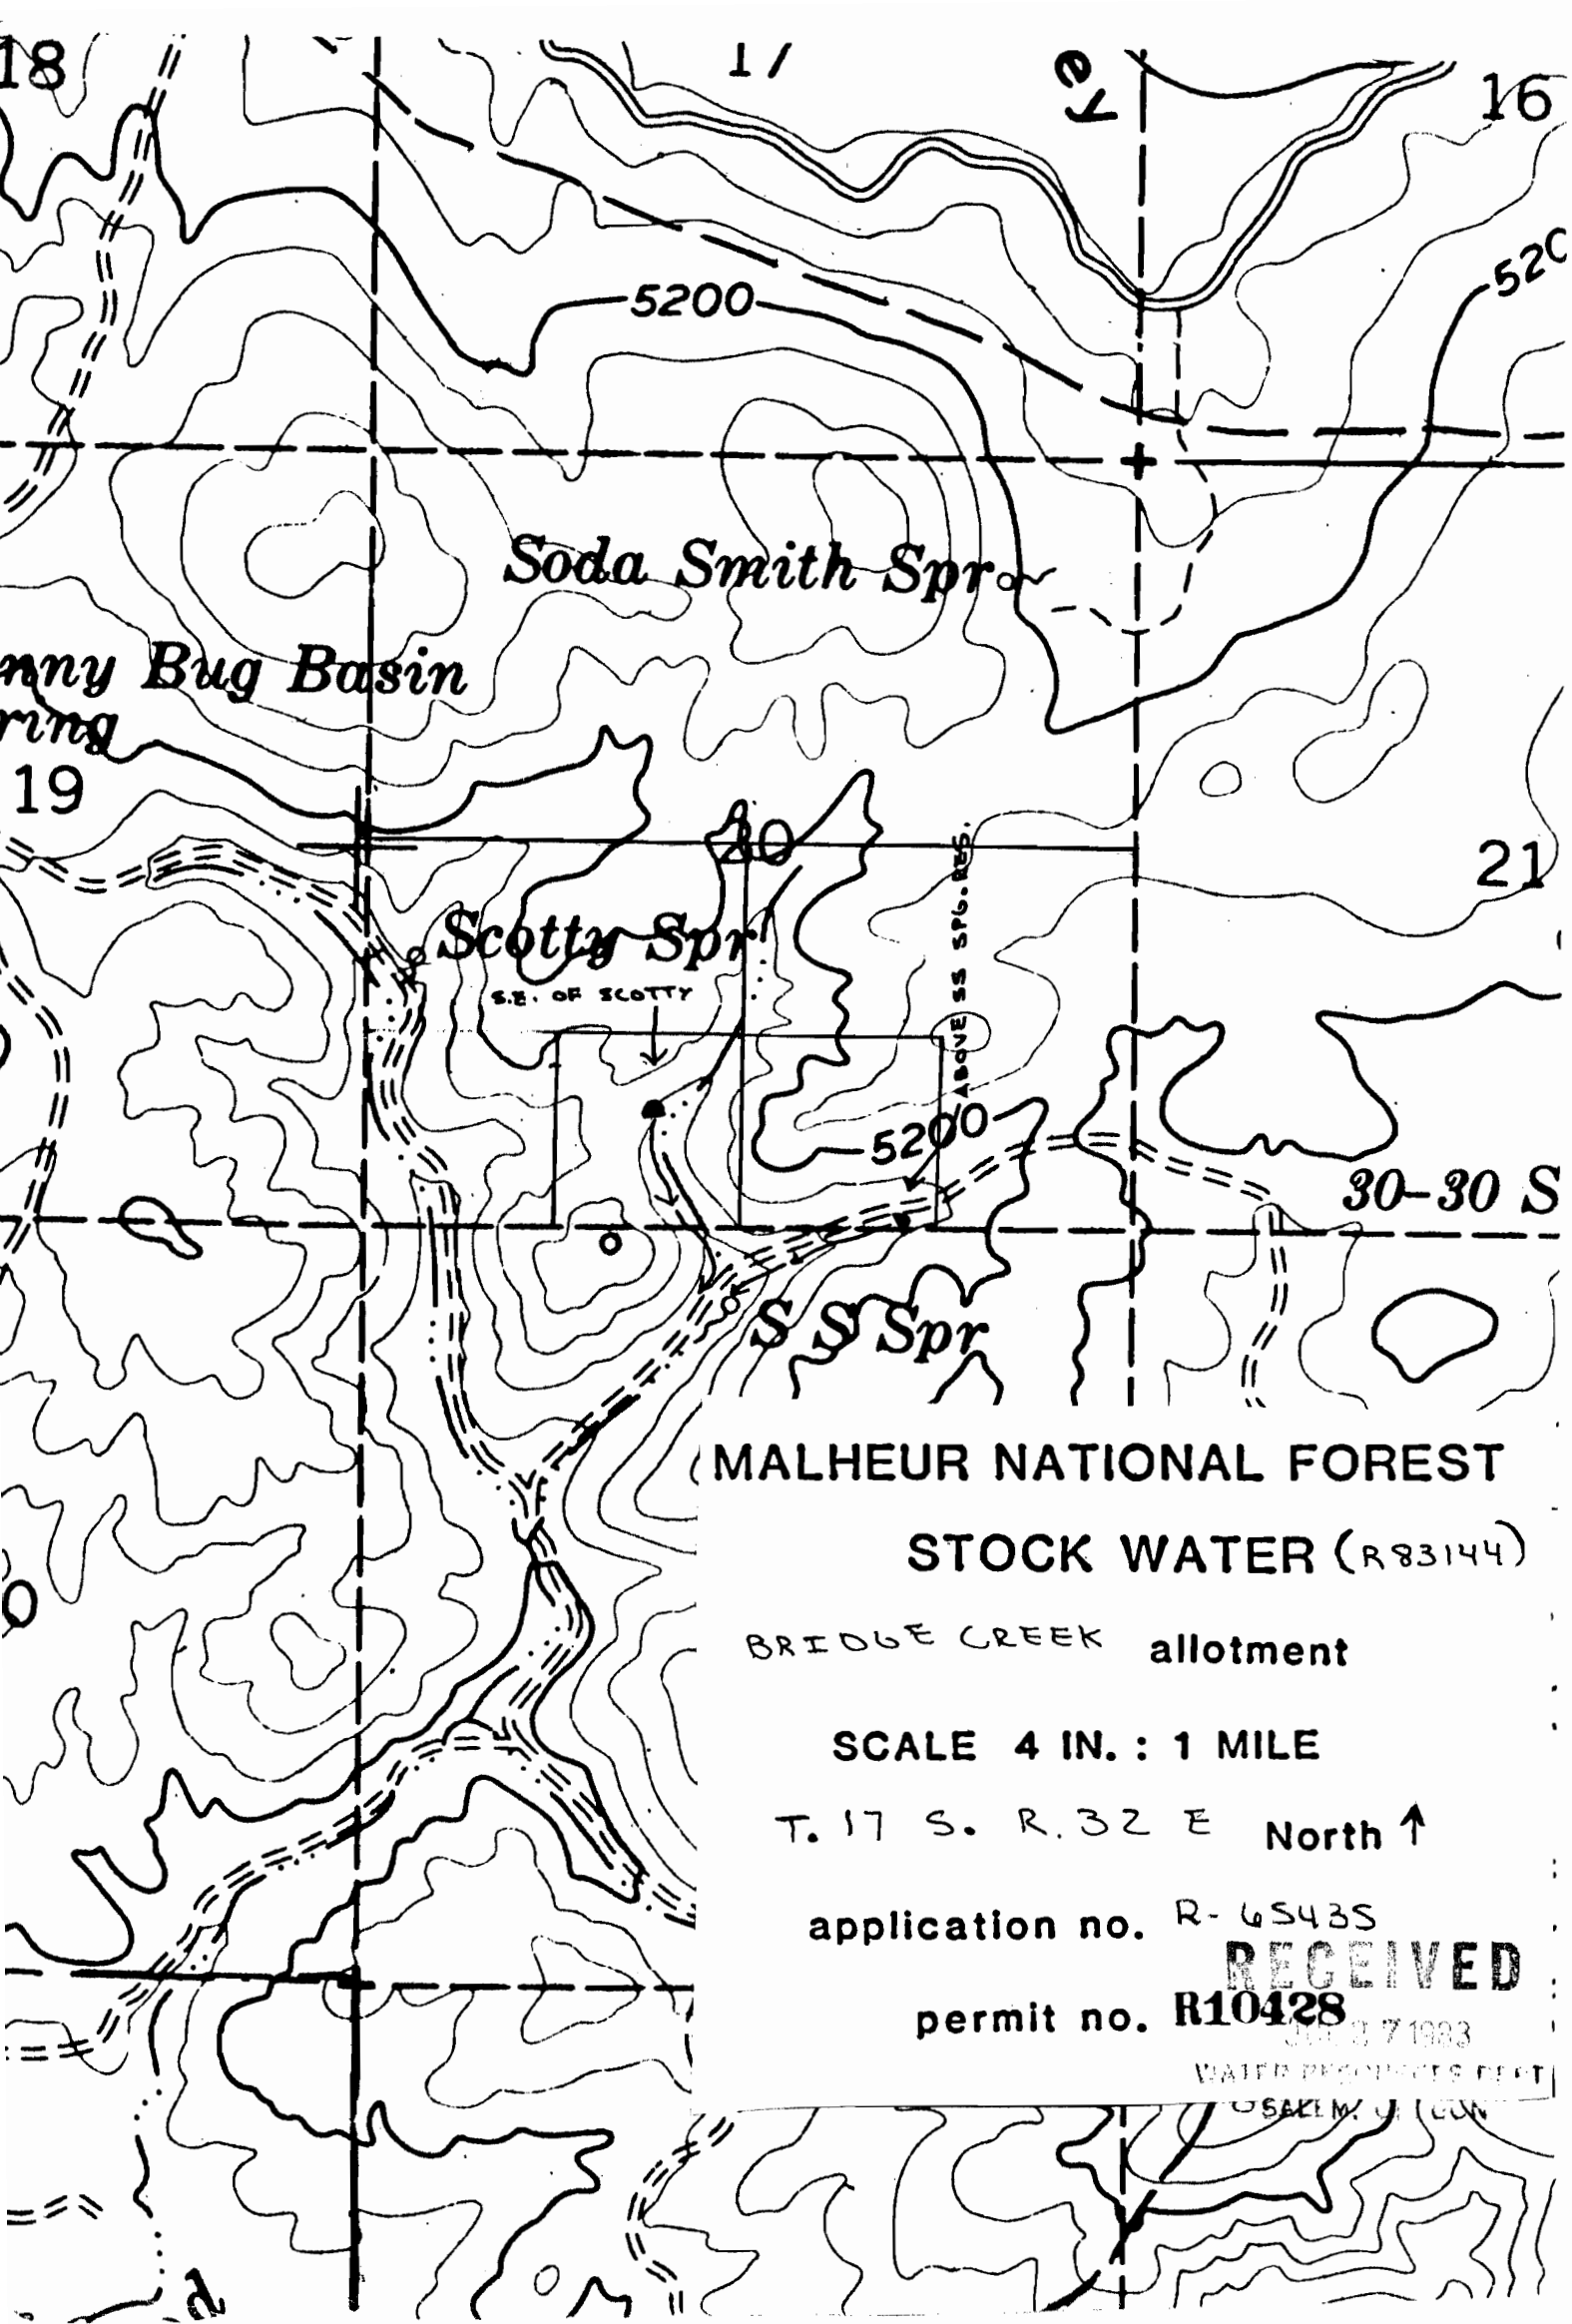

Soda Smith Spr.

Manny Bug Basin
ring
19

Scotty Spr.

S.E. OF SCOTTY

ABOVE SS SPG. RES.

5200

S.S. Spr.

30-30 S

MALHEUR NATIONAL FOREST

STOCK WATER (R83144)

BRIDGE CREEK allotment

SCALE 4 IN. : 1 MILE

T. 17 S. R. 32 E North ↑

application no. R-65435

permit no. R10428

RECEIVED

JUN 27 1983

WATER RESOURCES DEPT

