



Township 2 South, Range 4 East, W.M.
Section 4

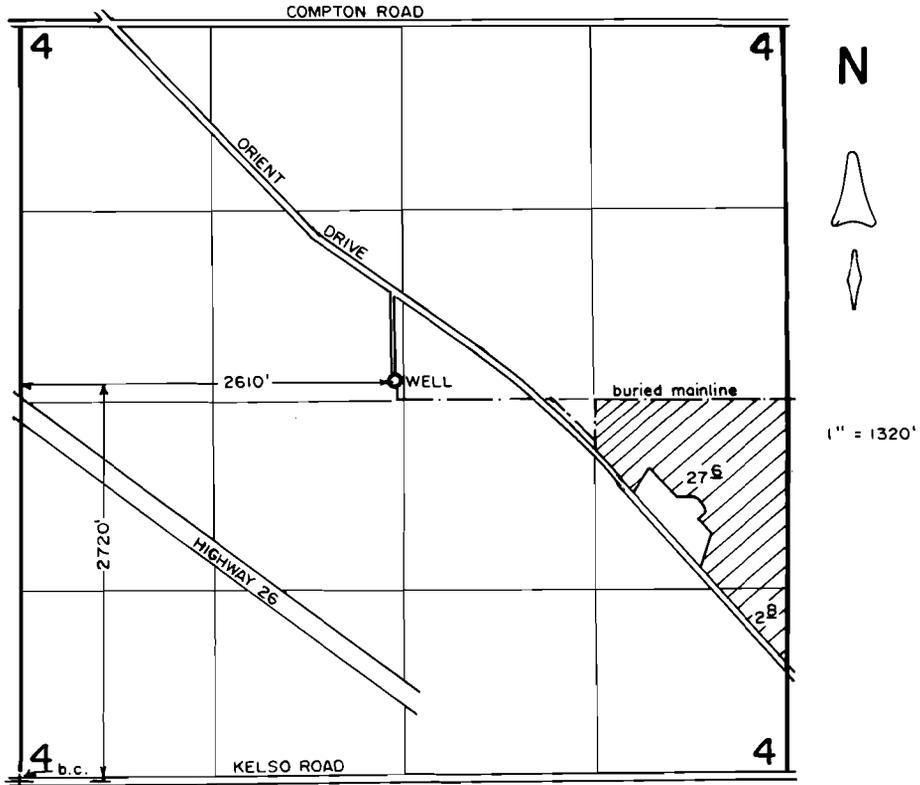

FINAL PROOF SURVEY
under
Appl. No. G-12395, Per. No. G-11636
in name of

J. FRANK SCHMIDT & SON CO.

November 3, 1994

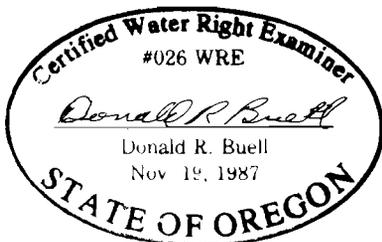

THIS MAP WAS PREPARED FOR THE PURPOSE OF IDENTIFYING THE LOCATION OF A WATER RIGHT ONLY AND IS NOT INTENDED TO PROVIDE LEGAL DIMENSIONS OR LOCATION OF PROPERTY OWNERSHIP LINES.