


T.19S. R.12W. W.M.

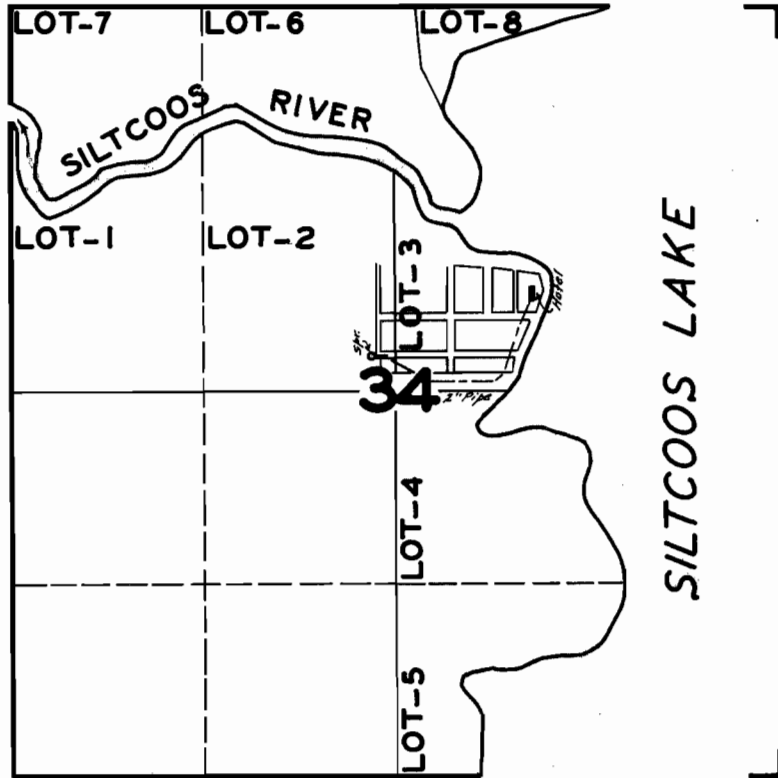

FINAL PROOF SURVEY
UNDER

Application No. 21215 Permit No. 16629

IN NAME OF
MAURINE LABER

Surveyed JAN. 5, 1946 by [Signature]

21805

25150

19784

1946-A