


T 7S., R. 38 & 39E., W.M.

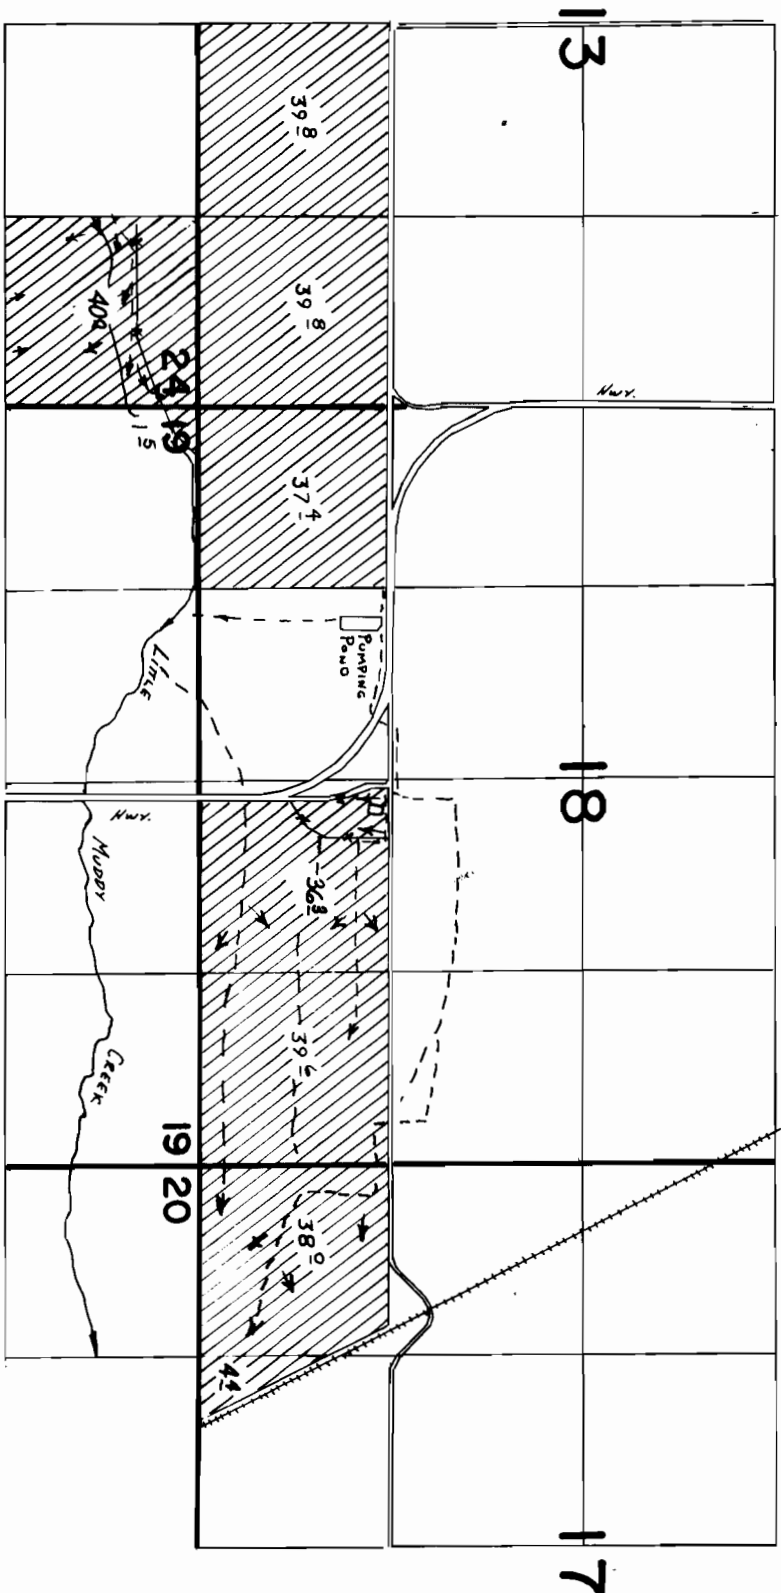

**FINAL PROOF SURVEY**

UNDER

T. 7S., R. 38E., W.M.

APPL. 59668 PER. 45216  
 IN NAME OF

MAXWELL RANCH

SURVEYED 7-19-1983, BY *R. C. Church*

