

T37 & 38S , R13E , W.M.

RECEIVED


PER REQUISITION
FOR RECORD



SCALE 1" = 1320'

LEGEND

- SECTION LINE
- - - 1/4, 1/4 SECTION LINE
- ~ CREEK
- - - DITCH
- ▨ AREA IRRIGATED
- #2 ● POINT OF DIVERSION AS NOTED IN TABLE
- DIRECTION OF FLOW FOR FLOOD IRRIGATION
- EXISTING DIKE

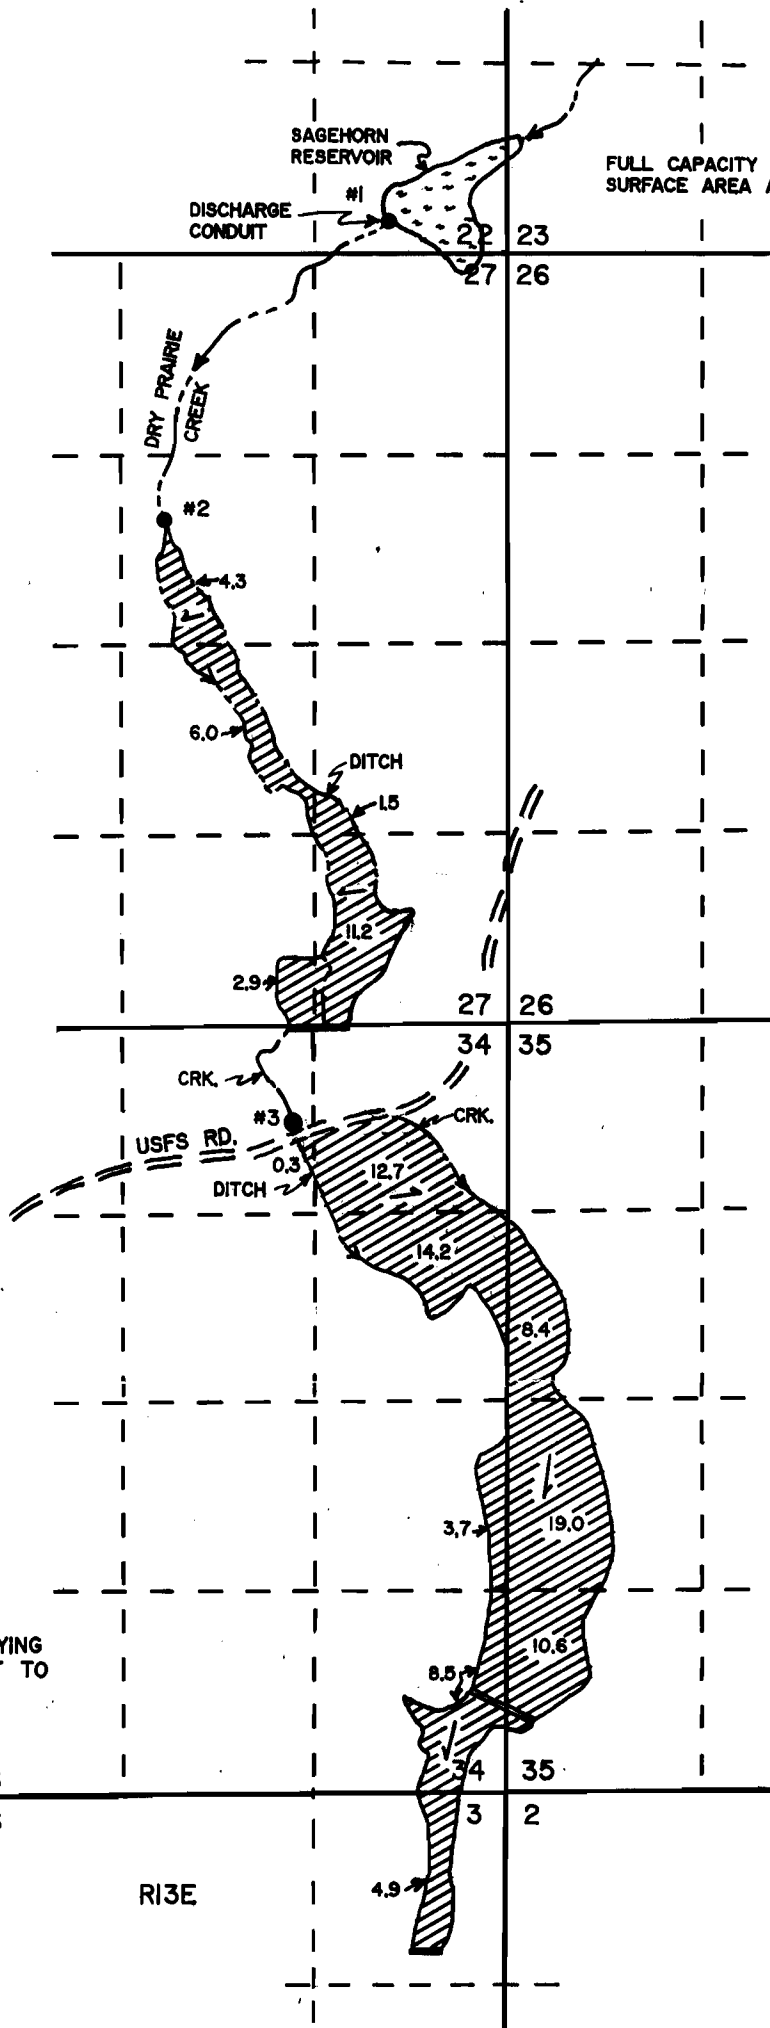

FULL CAPACITY OF RESERVOIR = 34.06 AC. FT.
SURFACE AREA AT FULL CAPACITY = 10.06 AC.

- POINT OF DIVERSION TABLE
- #1 233' NORTH AND 886' WEST FROM THE SE COR. SEC. 22, T37S, R13E
 - #2 3496' NORTH AND 2343' WEST FROM THE SE COR. SEC. 27, T37S, R13E
 - #3 823' SOUTH AND 1399' WEST FROM THE NE COR. SEC. 34, T37S, R13E

NOTE: PREPARATION OF THIS MAP IS FOR IDENTIFYING PROPOSED WATER RIGHTS ONLY. IT HAS NO INTENT TO PROVIDE LOCATIONS OR DIMENSIONS OF PROPERTY BOUNDARIES.

T37S
T38S

R13E

FINAL PROOF SURVEY
UNDER

APPLICATION NO. 69725 PERMIT NO. 50966
APPLICATION NO. R-69659 PERMIT NO. R-11220

IN THE NAME OF

LEO SAGEHORN
P.O. BOX 186
FT. BIDWELL , CA. 96112

SURVEYED JUNE 1, 1991



PREPARED BY:

ANDERSON ENGINEERING & SURVEYING
P.O. BOX 28
618 SOUTH FIRST STREET
LAKEVIEW, OREGON 97630
(503) 947-4407
JUNE 11, 1991

SHEET 1 OF 1

RECEIVED

SEP 2 1988

WATER RESOURCES DEPT.
SALEM, OREGON

RECEIVED

AUG - 9 1989

WATER RESOURCES DEPT.
SALEM, OREGON

THIS MAP IS PREPARED
TO ACCOMPANY APPLICATION
ONLY AND TO IDENTIFY
THE LOCATION OF THE
WATER USE. IT HAS
NO INTENT TO PROVIDE

DIMENSIONS OR
OWNERSHIP LINES.


RECEIVED

WATER RESOURCES DEPT.
SALEM, OREGON

RANGE 13 E

TOWNSHIP 37 S

TOWNSHIP 38 S

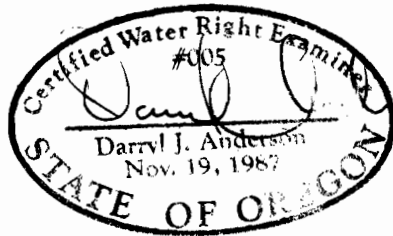

STOCKWATER - DIRECTLY OUT
OF RESERVOIR

EXISTING RESERVOIR
AND DAM - SEE
APPLICATION # R-69659

U.S. FOREST SERVICE
OWNERSHIP

DRY PRARIE
CREEK

Div. Pt. from crk.
1595' S. & 2125' W from
NE cor. Sec. 27

POINT OF DIVERSION
FROM RESERVOIR

850' WEST AND 270' NORTH
OF THE SOUTHEAST CORNER
OF SECTION 22

STOCKWATER - OUT OF NATURAL
CHANNEL IN THIS AREA

NORTH

SCALE
1"=1320'

SAGEHORN OWNERSHIP
WITHIN HEAVY LINE

Div. Pt. from crk.
950' S. & 1385' W. from
NE cor. Sec. 34

ACRES IRRIGATED 15.5
PER 1/4-1/4 SECTION 22

U.S. FOREST SERVICE
OWNERSHIP

CROSS-HATCHED AREA
INDICATES LAND TO
BE IRRIGATED WITH
STORED WATER FROM
RESERVOIR

PRIMARY RIGHT OF
APPLICANT - REFER TO
PROOF OF CLAIM FILED
6/15/82 BY LEO SAGEHORN.
ALSO REFER TO LOST
RIVER ADJUDICATION
PROCEEDINGS.

MAP PREPARED FROM
INFORMATION FURNISHED
BY OWNER

MAP TO ACCOMPANY APPLICATION
FOR STORED WATER TO BE USED
TO SUPPLEMENT AN EXISTING RIGHT
FOR

LEO SAGEHORN

Application No. R-69659 & 69725

Permit No. R-14220 & 50966

ANDERSON ENGINEERING & SURV.
P.O. BOX 28
LAKEVIEW, OR.
97630