


T37 & 38S , R13E , W.M.



SCALE 1" = 1320'

LEGEND

- SECTION LINE
- - - 1/4, 1/4 SECTION LINE
- - - CREEK
- - - DITCH
- ▨ AREA IRRIGATED
- #2 ● POINT OF DIVERSION AS NOTED IN TABLE
- DIRECTION OF FLOW FOR FLOOD IRRIGATION
- EXISTING DIKE

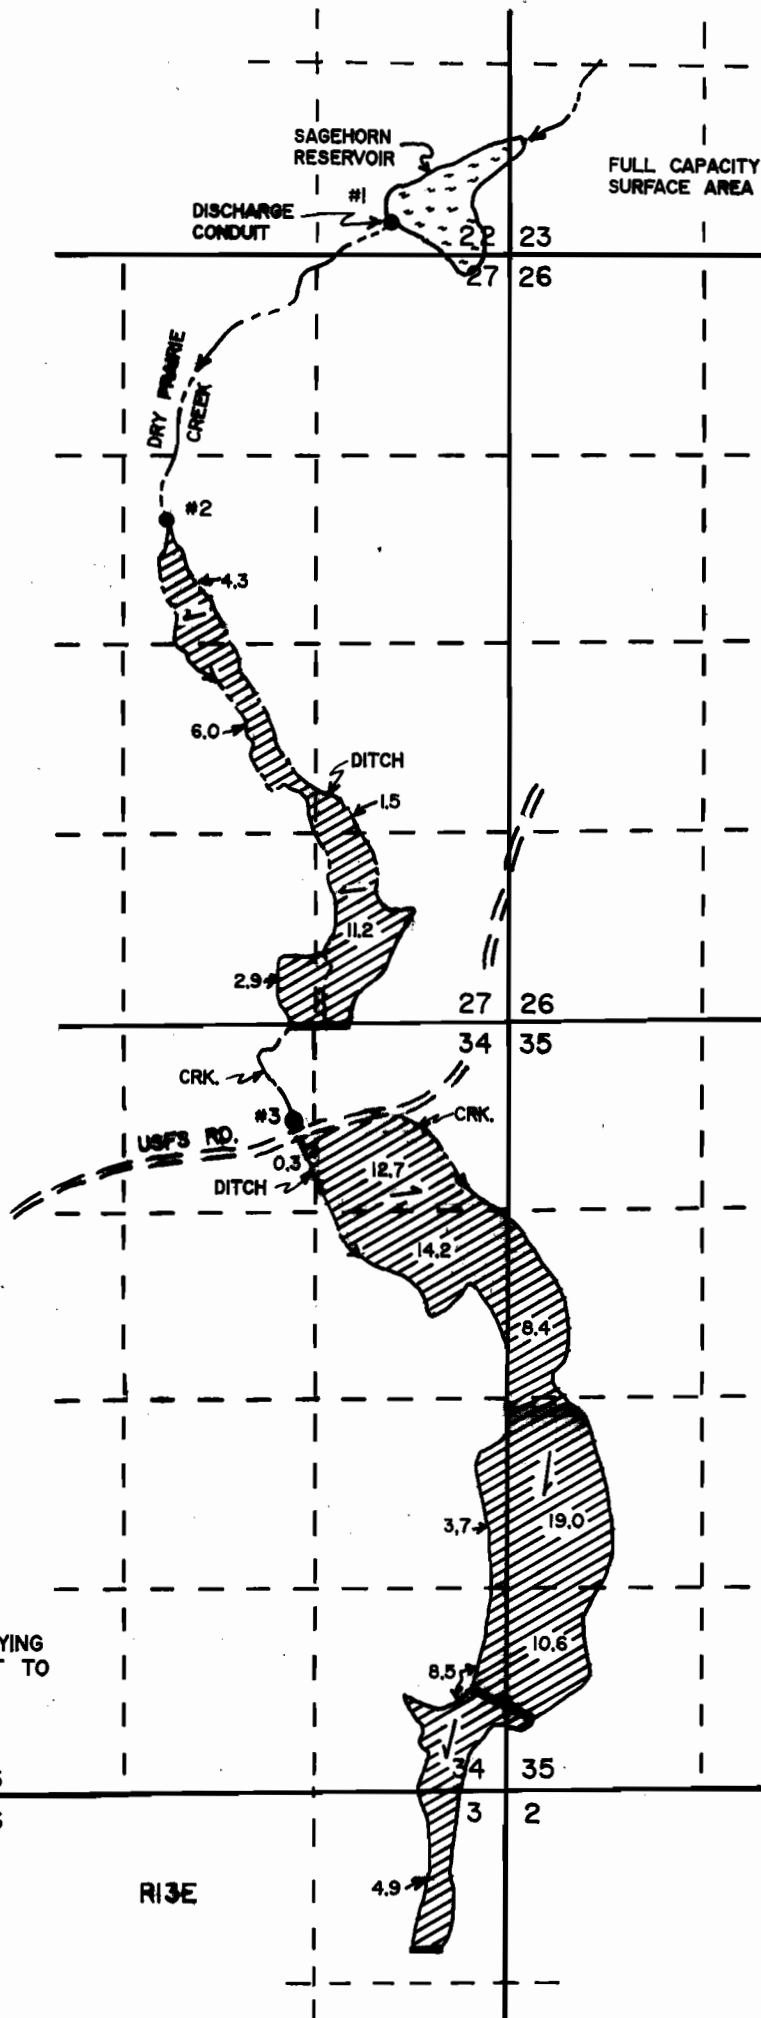

FULL CAPACITY OF RESERVOIR = 34.06 AC. FT.
SURFACE AREA AT FULL CAPACITY = 10.06 AC.

POINT OF DIVERSION TABLE

- #1 233' NORTH AND 886' WEST FROM THE SE COR. SEC. 22, T37S, R13E
- #2 3496' NORTH AND 2343' WEST FROM THE SE COR. SEC. 27, T37S, R13E
- #3 823' SOUTH AND 1399' WEST FROM THE NE COR. SEC. 34, T37S, R13E

NOTE: PREPARATION OF THIS MAP IS FOR IDENTIFYING PROPOSED WATER RIGHTS ONLY. IT HAS NO INTENT TO PROVIDE LOCATIONS OR DIMENSIONS OF PROPERTY BOUNDARIES.

T37S
T38S

R13E

FINAL PROOF SURVEY

UNDER

APPLICATION NO. 69725 PERMIT NO. 50966
APPLICATION NO. R-69659 PERMIT NO. R-11220

IN THE NAME OF

LEO SAGEHORN
P.O. BOX 186
FT. BIDWELL, CA. 96112

SURVEYED JUNE 1, 1991



PREPARED BY:

ANDERSON ENGINEERING & SURVEYING
P.O. BOX 28
618 SOUTH FIRST STREET
LAKEVIEW, OREGON 97630
(503) 947-4407
JUNE 11, 1991

SHEET 1 OF 1