


T.6S. R.4W. W.M.

POLK COUNTY

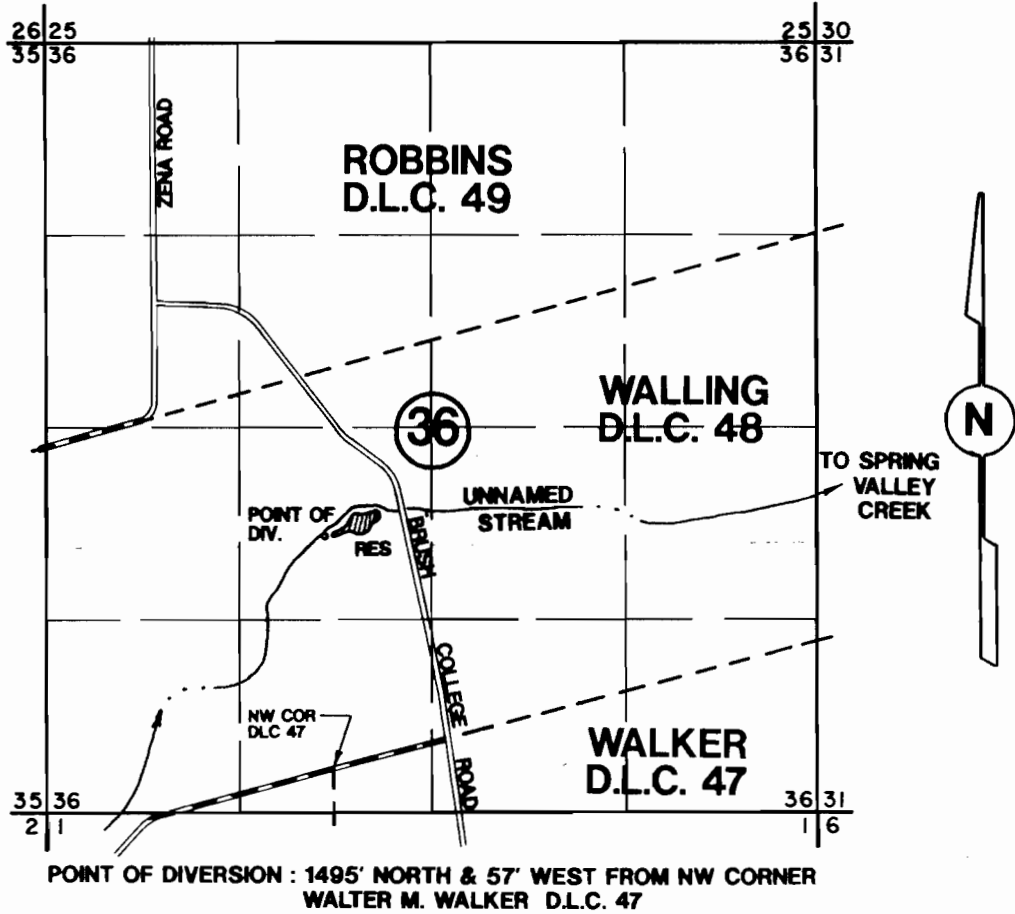

FINAL PROOF SURVEY

Application No R-71801 71802 Permit No R-11406 51338

RUSSELL BASS

Scale : 1320'
September 19, 1993

NOTE: This map is for the purpose of identifying the location of water rights and has no intent to dimension or locate property ownership lines.

