


T. 13 S., R. 37 E., W.M.

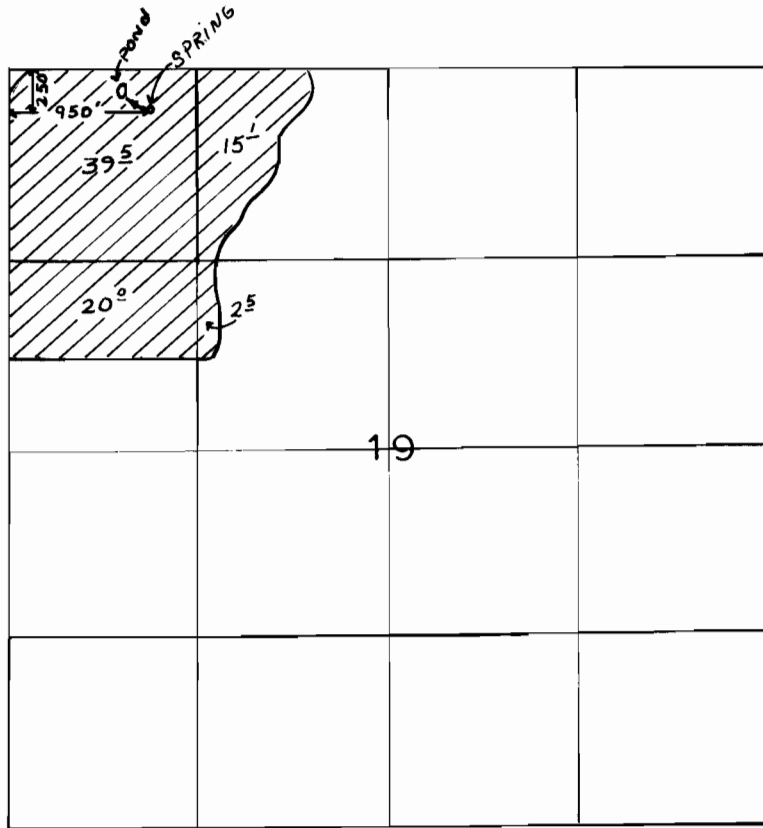

FINAL PROOF SURVEY

UNDER

Application No. 58352 Permit No. 48742

IN NAME OF

MARVIN J. AND MARJORIE M. SHOLLENBERGER

Surveyed 6-10, 1993, by J. MILLER