



PORTLAND GOLF CLUB  
 5900 SW Scholls Ferry Road  
 Portland, Oregon 97255  
 TIS, RIW, W. M.

**APPLICATION R-70184**  
**PERMIT R-11264**

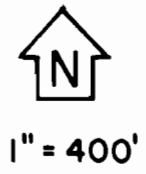

This drawing is an exhibit for a Reservoir Permit. It is not a Land Survey. Property lines and/or other lines of occupation shown hereon are not represented by the undersigned to meet accuracy standards of Land Surveys.

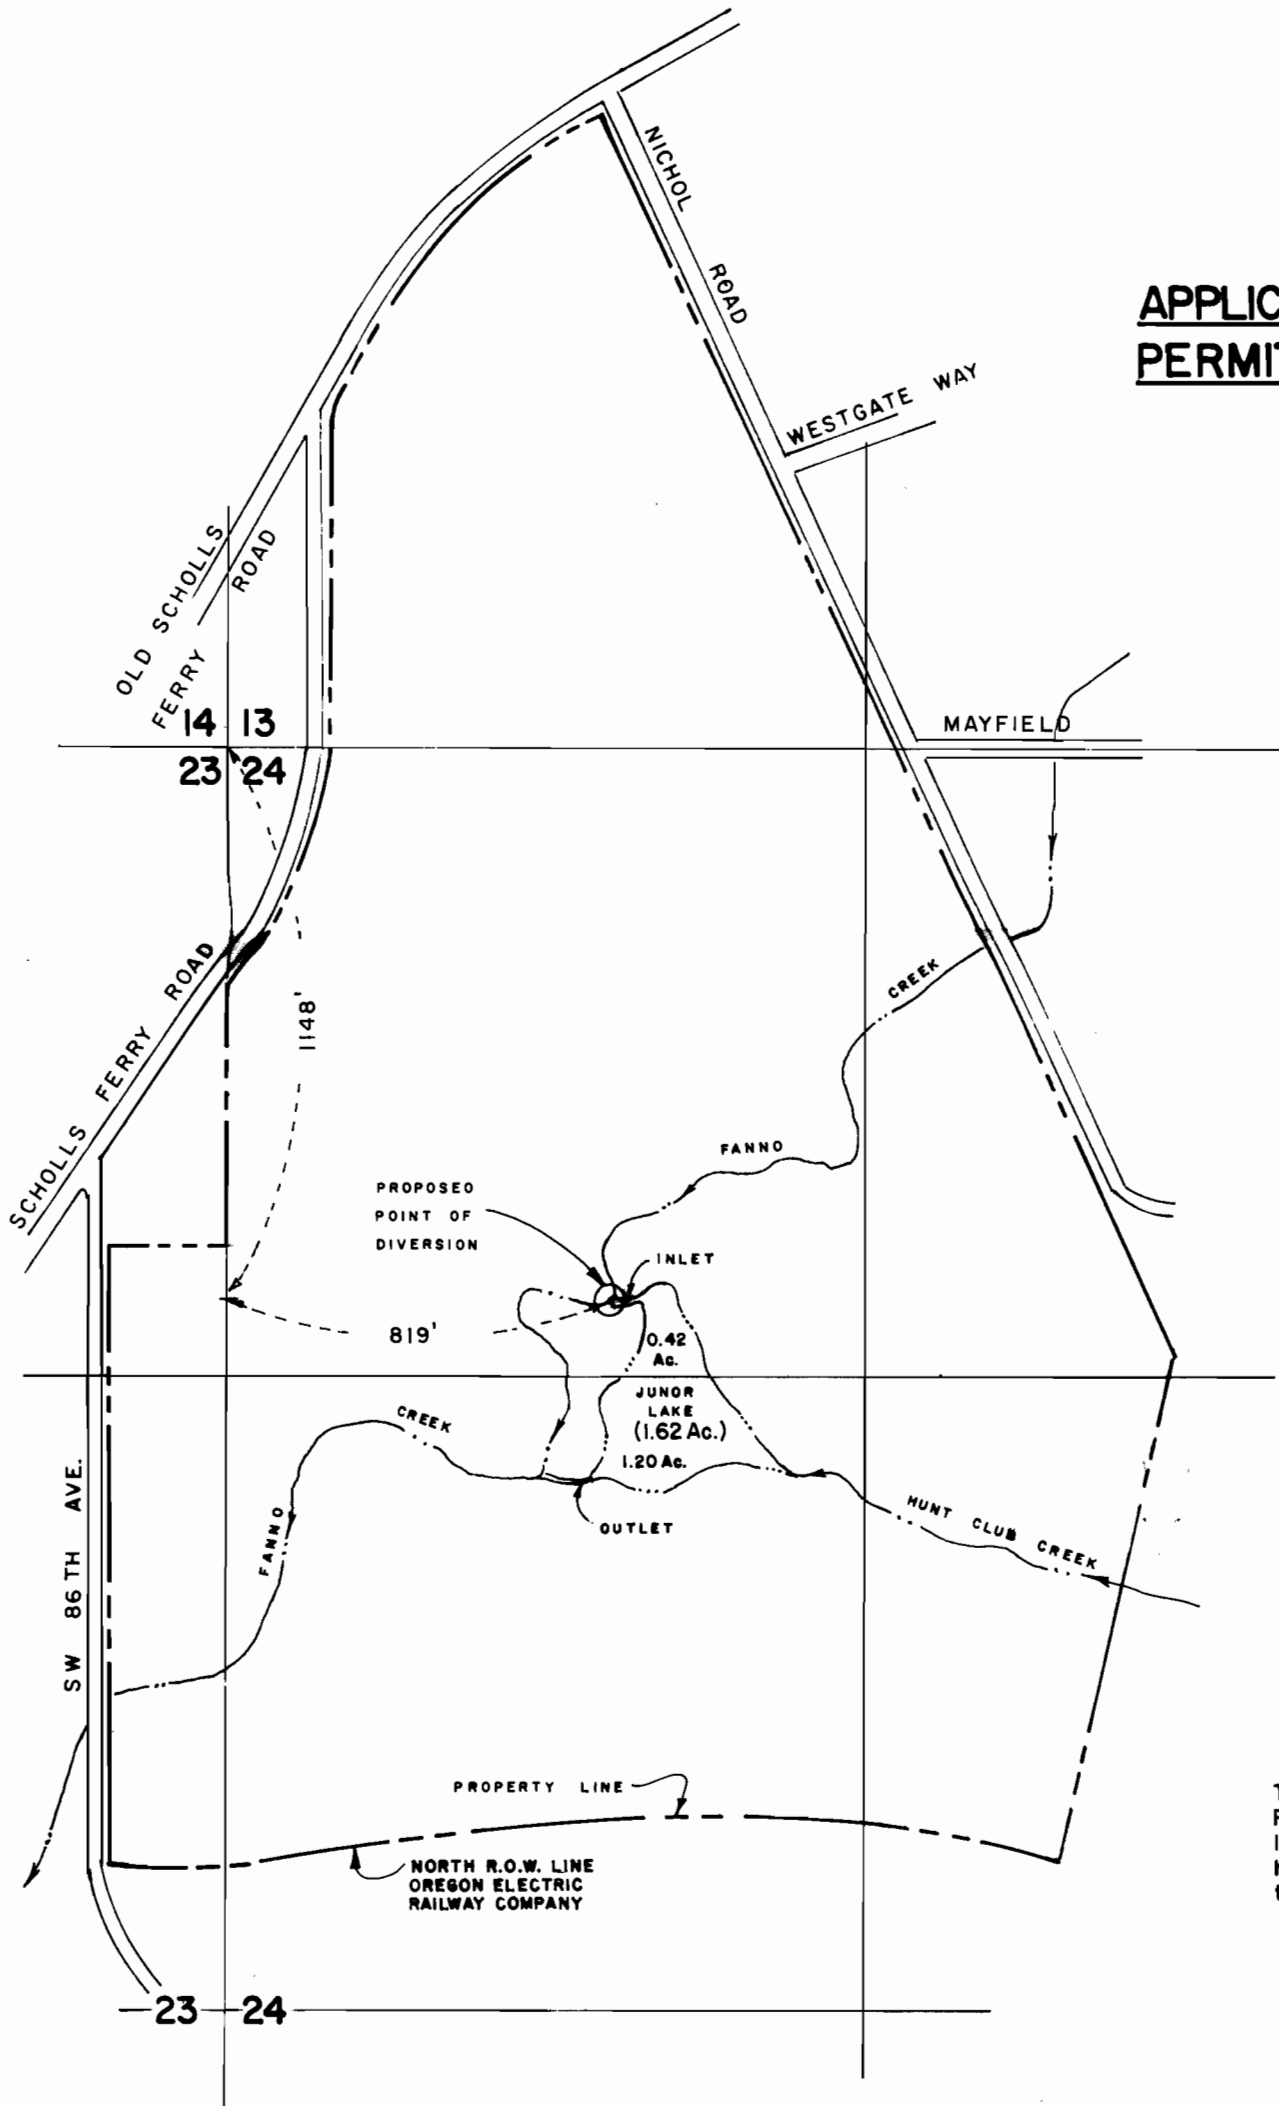

**HANER, ROSS & SPORSEEN, INC.**  
 ENGINEERS                      CONSULTANTS                      SURVEYORS  
 GLADSTONE                      OREGON

**FINAL PROOF SURVEY**  
**RESERVOIR**