


TOWNSHIP 9 SOUTH, RANGE 19 EAST, W.M.

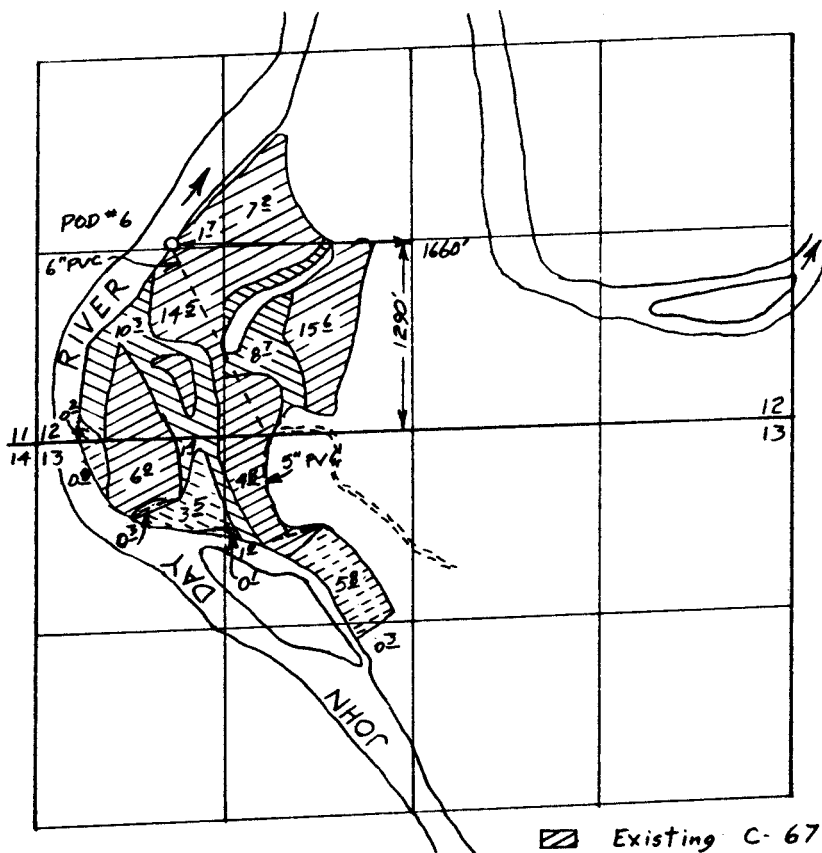

Scale 1" = 1320'


Surveyed Sept. 22, 1993

- Existing C- 67640 (1900)
- T-6737 (1900)
- Existing C- 67885 (23 Feb 83)
- T-6737 (23 Feb 83)

CLAIM OF BENEFICIAL USE MAP
TRANSFER T-6737
for
DERBY SMITH PARTNERS

RECEIVED

DEC 10 1993

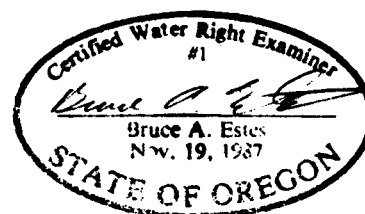WATER RESOURCES DEPT
SALEM, OREGON

This map is for the purpose of locating a water right only and has no intent to provide the location of property lines or legal dimensions.