


T. 9S. R. 1W. W.M.

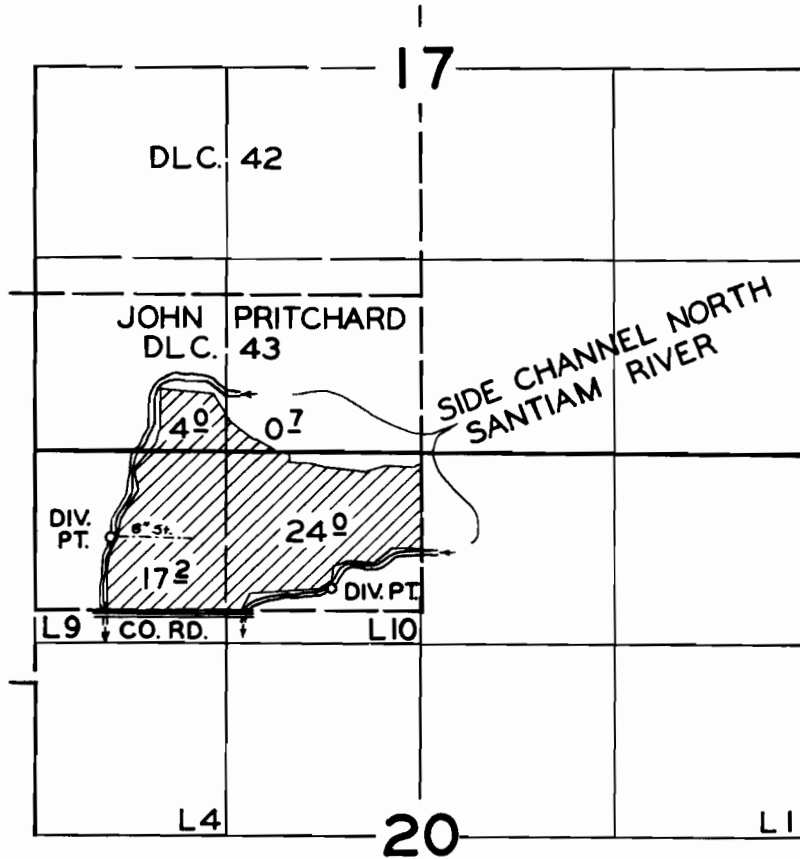

**FINAL PROOF SURVEY**  
UNDER

Application No. 26807 Permit No. 21054  
IN NAME OF

**LERA M. & VERNON SNODDY**

Surveyed MAY 22 1958, by *C. O. Bartels*