


# T.4 N.27 E.W.M.

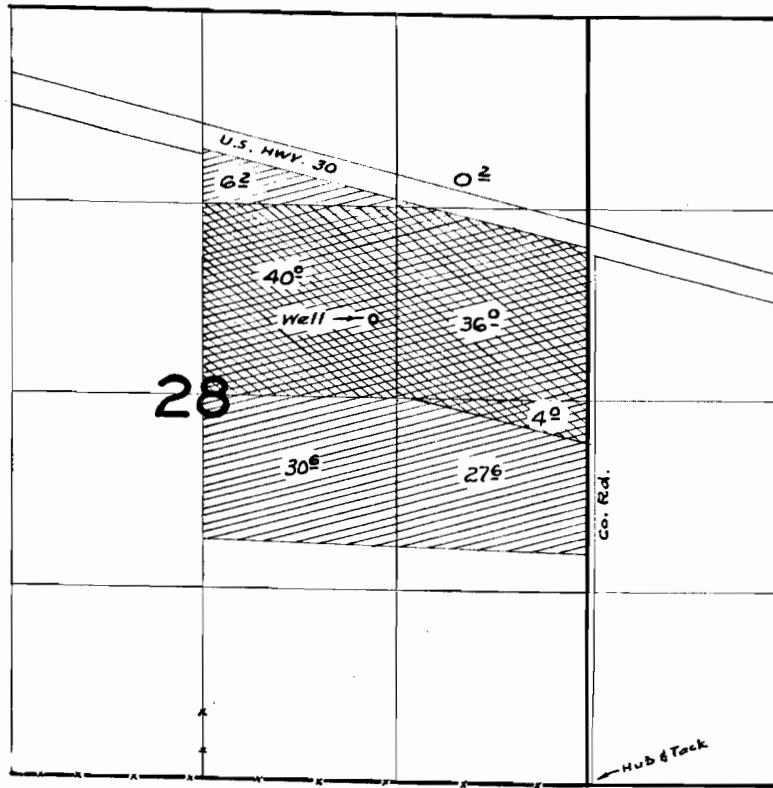

## FINAL PROOF SURVEY UNDER

Application No. G-139 Permit No. G-100  
U-545 U-498

IN NAME OF

SYLVANUS F. HOYT

Surveyed 15 Oct. 1958, by m. Bieh