


T. 6 S. R. 2 W. W. M.

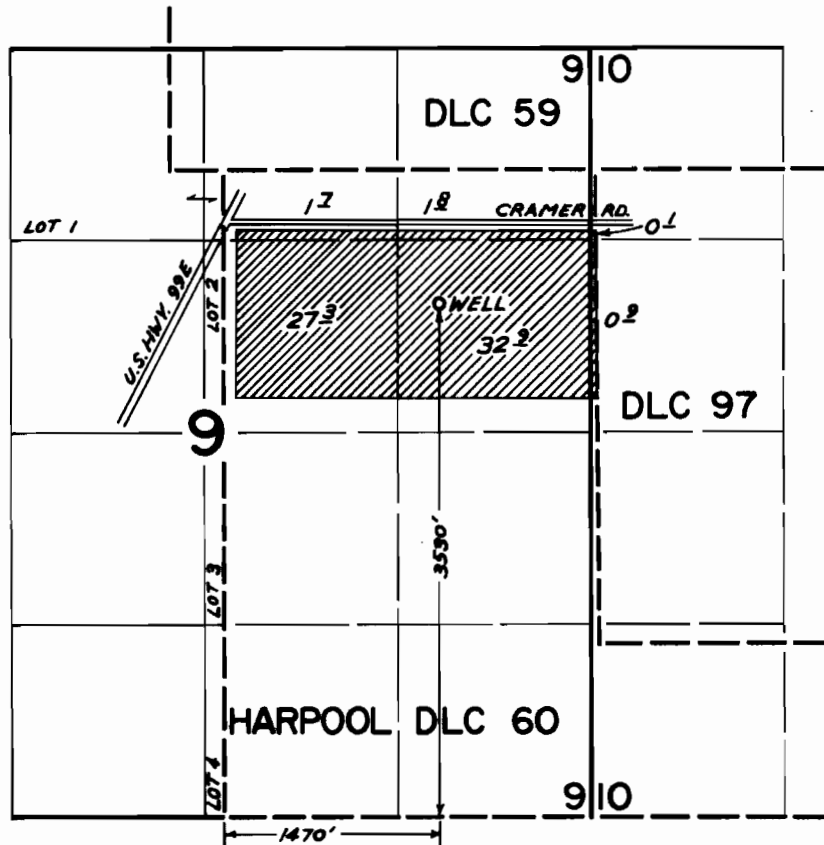

FINAL PROOF SURVEY UNDER

Application No. G-3935 Permit No. G-3454
IN NAME OF

FRANK A. PETZEL

Surveyed JULY 26 1971, by GREG BACA