


T.7&8S. R.3W.W.M.

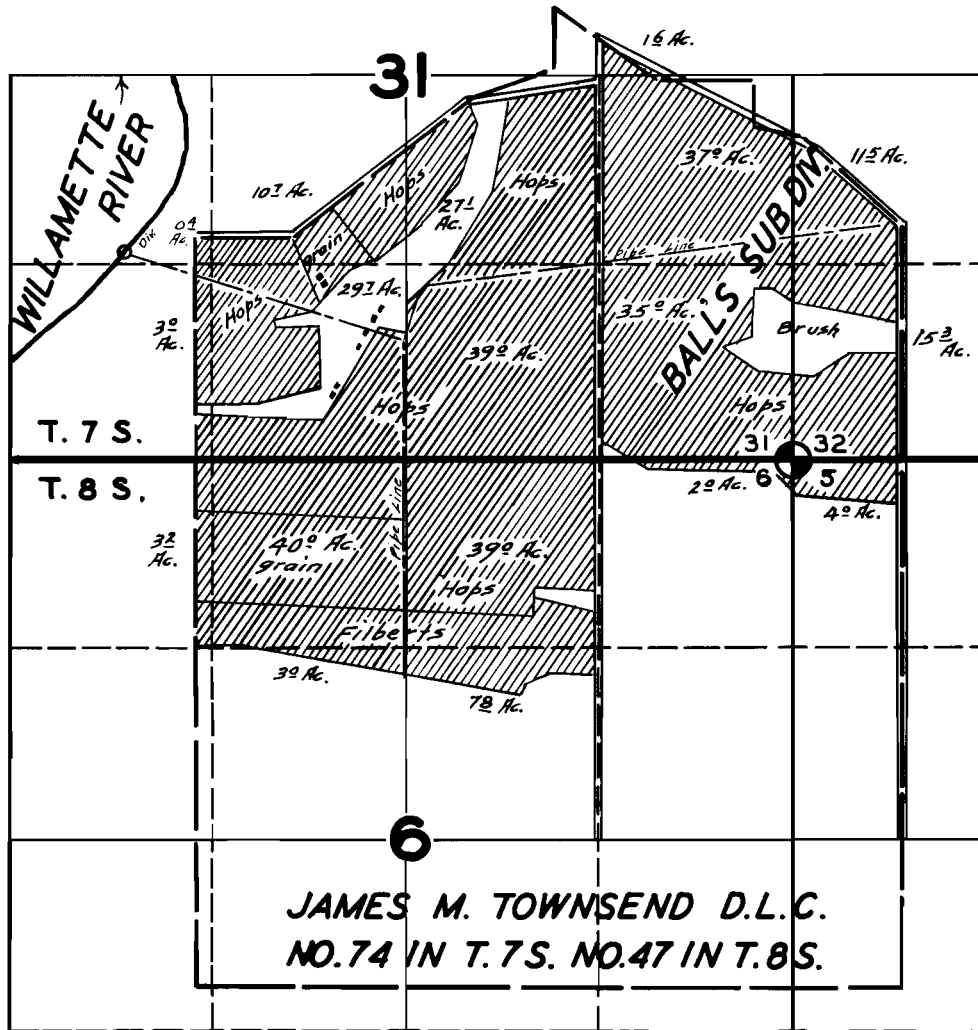

JAMES M. TOWNSEND D.L.C.
NO.74 IN T.7S. NO.47 IN T.8S.

FINAL PROOF SURVEY UNDER

Application No. 19281 Permit No. 14874

IN NAME OF

JOHN J. ROBERTS & CO.

