


T. 5S., R. 1W., W.M.

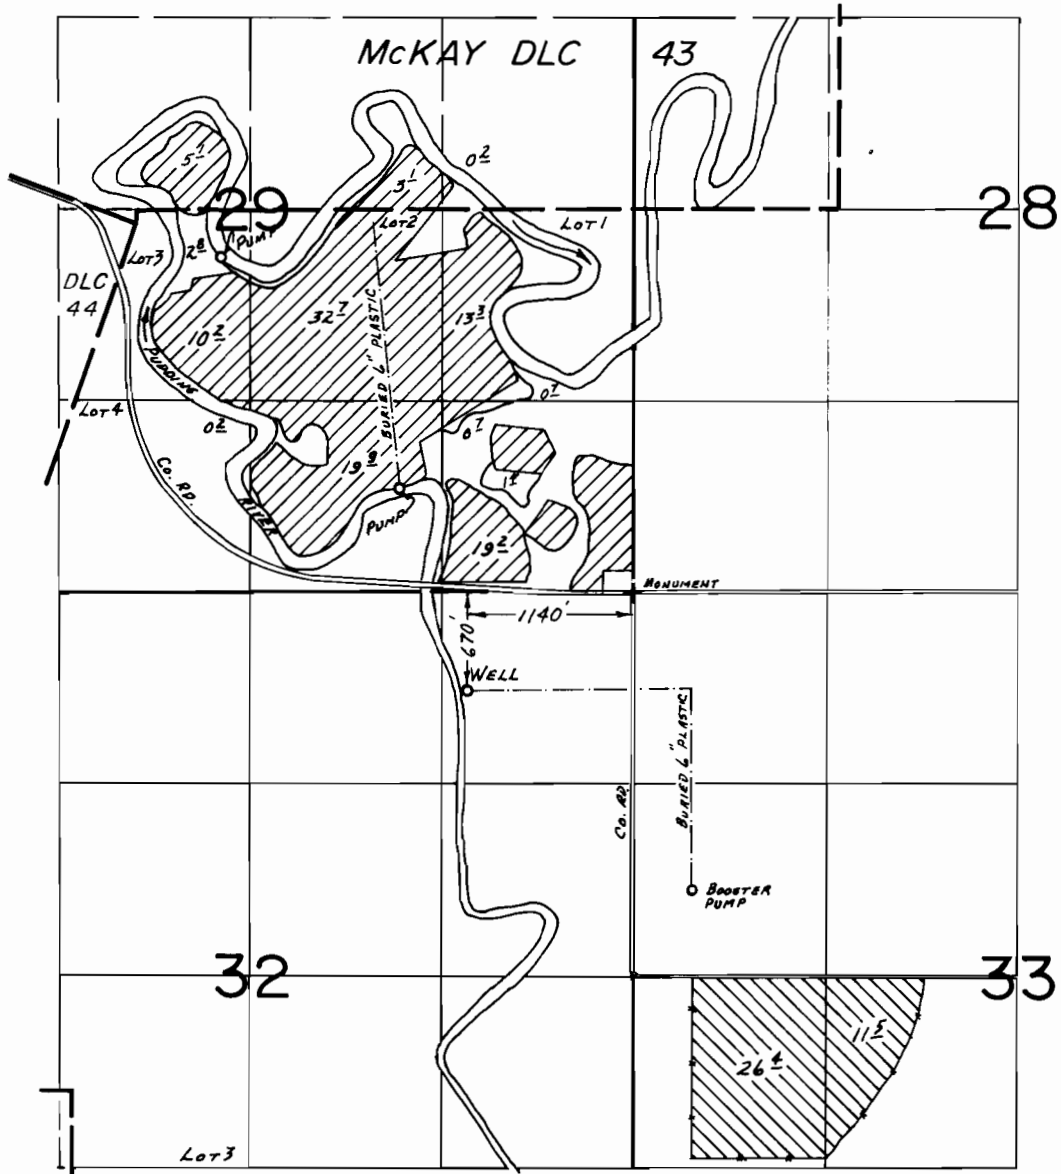

 PRIMARY
 SUPPLEMENTAL

FINAL PROOF SURVEY UNDER

Application No. G-8126.. Permit No. G-7501.....
IN NAME OF

.....LEONARD OBERSINNER.....

Surveyed May 15... 1980.. by B.W. BISHOP.....