
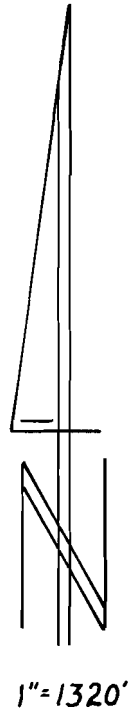


T. 2 N., R. 9 & 10 W., W.M.

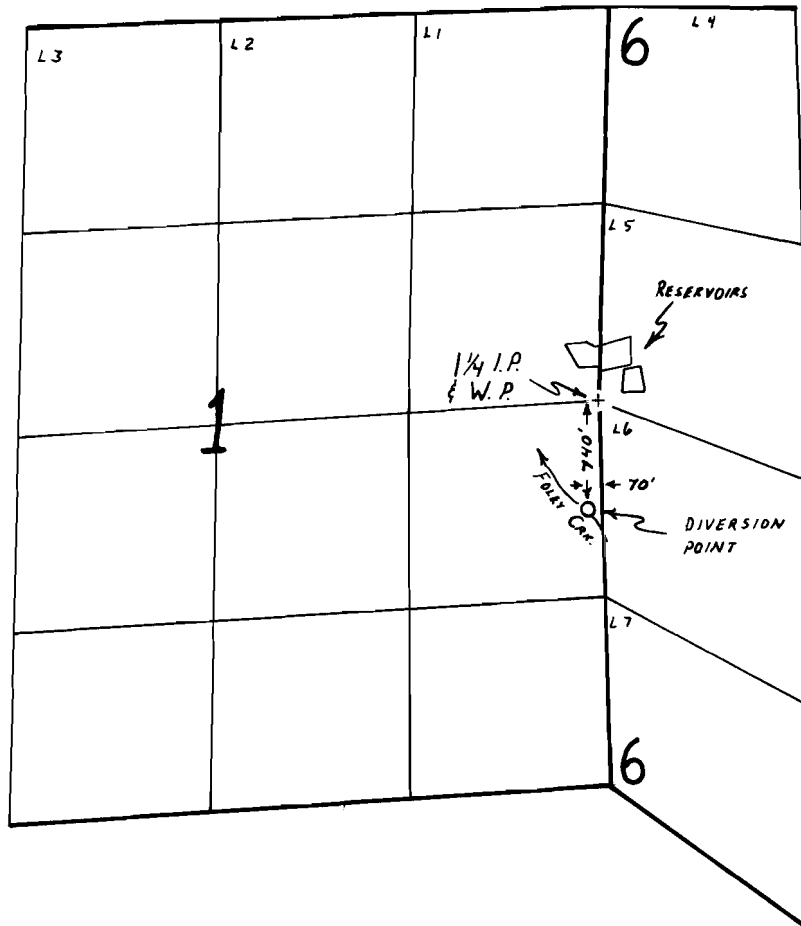

FINAL PROOF SURVEY

UNDER

Application No. R-59784 59785 Permit No. R-8001 44719
IN NAME OF

DAVID R. & MARY J. WEST

Surveyed SEPTEMBER 23, 1992, by R.W. Klassen