
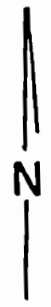


RECEIVED

SEP 22 1995

WATER RESOURCES DEPT.
SALEM, OREGON

T. 39 S., R. 3 W., W. M.

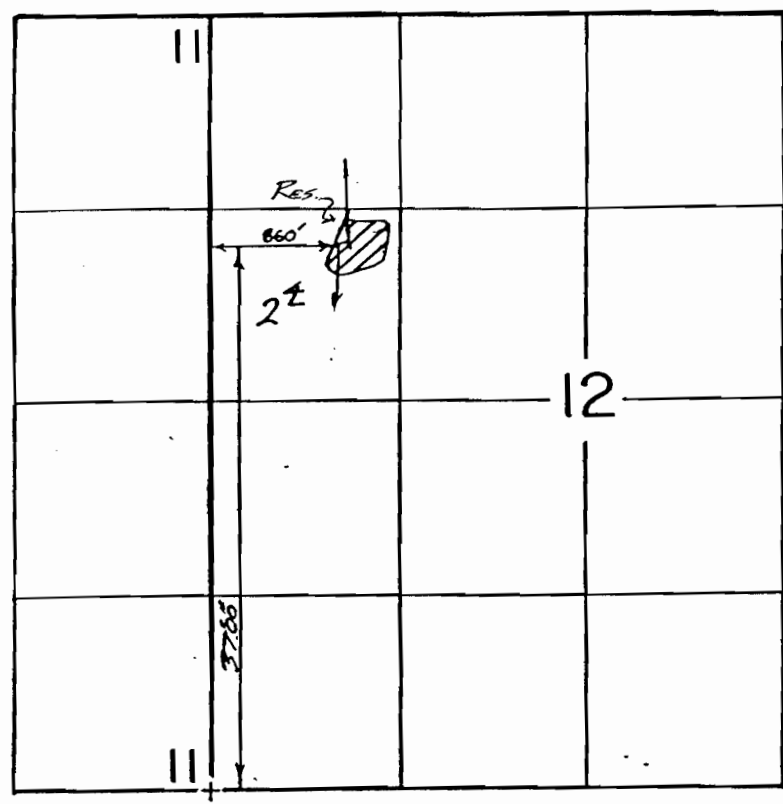

Scale 1" = 1320'

FINAL PROOF SURVEY UNDER

R-61558 R-8306
 Application No. 61559 Permit No. 46010
 IN NAME OF

..... LOREN R. GINGG
 11-13-87
 Surveyed 4-1-93 19..... by S. DeHaas

61559-378-478