


RECEIVED

T. 39 S., R. 3 W., W. M.

SEP 29 1995
WATER RESOURCES DEPT.
SALEM, OREGON

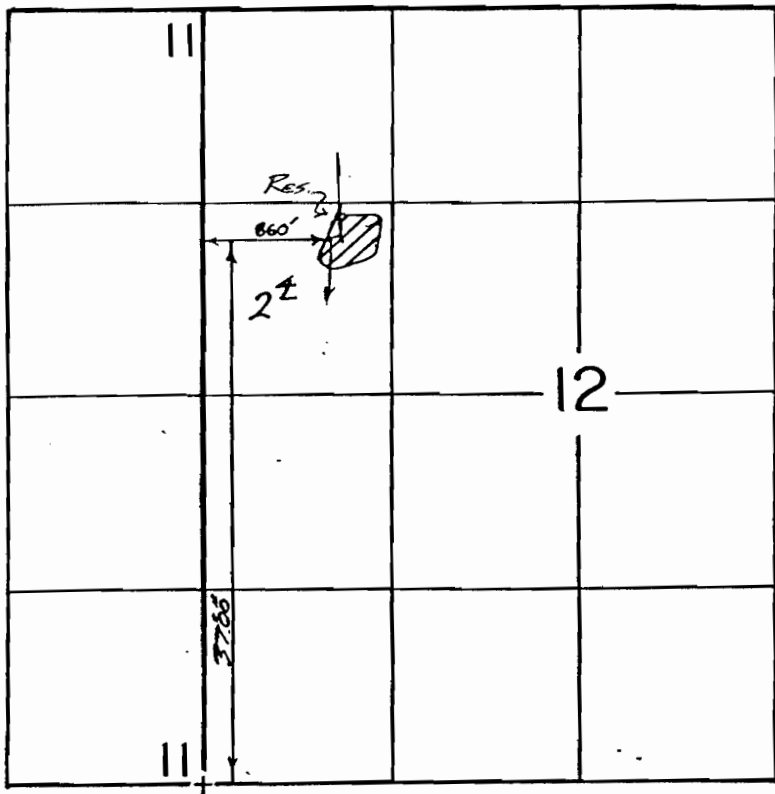

Scale 1" = 1320'

FINAL PROOF SURVEY UNDER

R-61558 R-8306
Application No. 61559 Permit No. 46010
IN NAME OF

..... LOREN R. GINGG

11-13-87
Surveyed 4-1-93 19..... by S. DeHaas