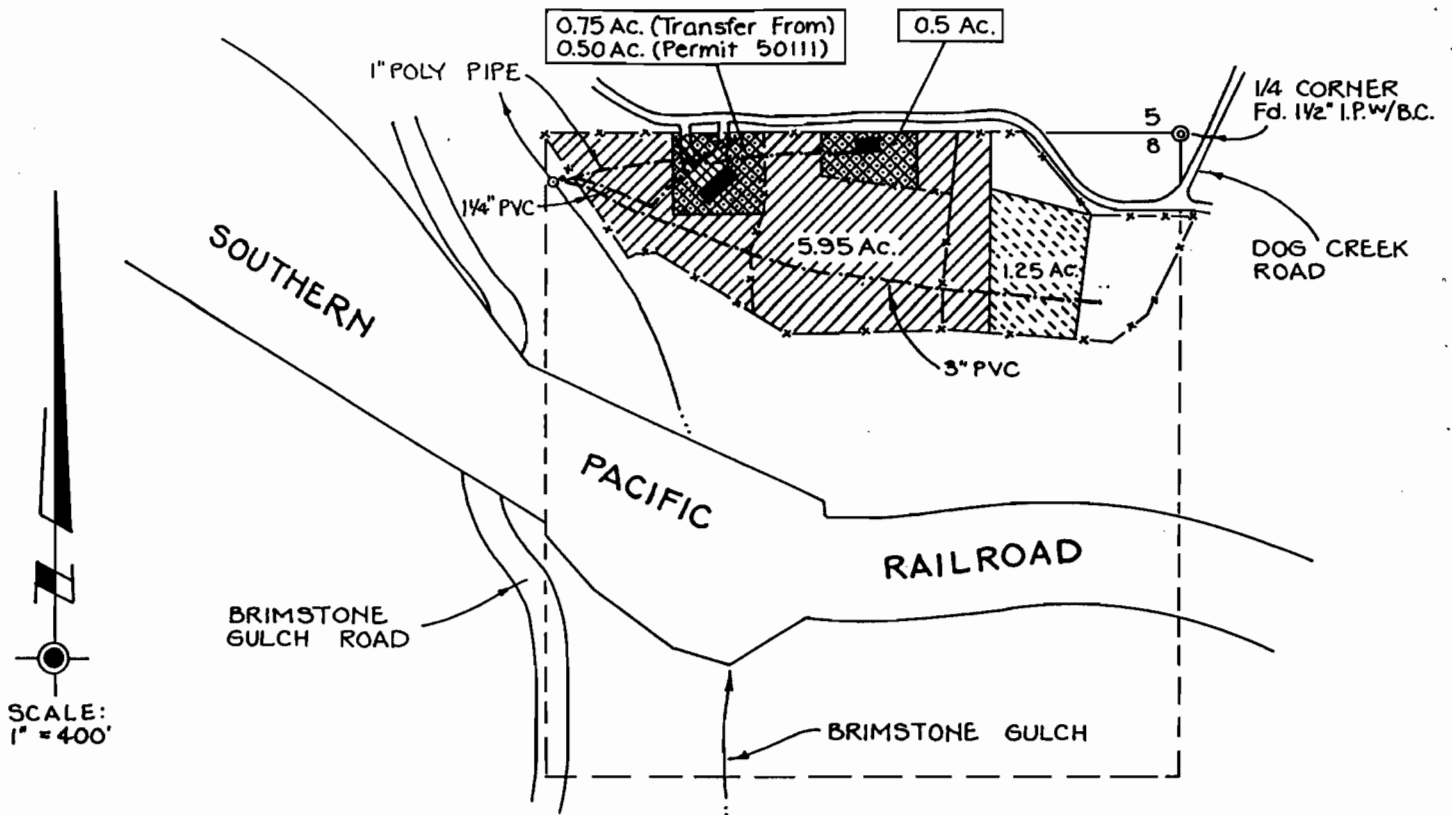


NE 1/4 NW 1/4 SEC. 8, T. 34 S., R. 6 W., W.M.



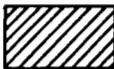


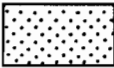




THE TIES TO THE DIVERSION POINT ARE BASED UPON A RECORD BEARING OF N 89° 30' W FOR THE N. LINE OF SEC. 8 PER SURVEY NO. 128-56.

SURVEY TIES WERE MADE USING A WILD T-1600 THEOMAT AND A DISTOMAT DI-1000 E.D.M.I.

THIS PLAT WAS PREPARED FOR THE PURPOSE OF IDENTIFYING THE LOCATION OF THE WATER RIGHT FOR TRANSFER ORDER NO. T-6034 AND PERMIT NO. 50111 ONLY. THERE IS NO INTENT TO PROVIDE DIMENSIONS OR LOCATIONS OF PROPERTY OWNERSHIP LINES.

A THREE PAGE SITE REPORT ACCOMPANIES THIS PLAT.

LEGEND

-  AUTHORIZED PLACE OF USE AS SHOWN ON THE FINAL PROOF SURVEY PLAT FOR CERTIFICATE NO. 34563
-  EXISTING PLACE OF USE (TRANSFER FROM) PER TRANSFER ORDER NO. T-6034 (1.25 Acres)
-  PROPOSED PLACE OF USE (TRANSFER TO) PER TRANSFER ORDER NO. T-6034 (1.25 Acres)
-  AUTHORIZED PLACE OF USE PER PERMIT NO. 50111 (1.00 Acres)
-  POINT OF DIVERSION (96' S. & 1309' W. OF N 1/4 COR. SEC. 8)
-  APPROXIMATE LOCATION OF BURIED PIPE
-  HOUSE
-  PUMPHOUSE

REVISED SEPT. 5, 1991

PROJECT NO.
144-90-122

DRAWING NO.
21-8.5.11

DATE
8-28-90

SCALE
1" = 400'



PLAT OF
CLAIM OF BENEFICIAL USE
LOCATED IN
NE 1/4 NW 1/4 SEC. 8, T. 34 S., R. 6 W., W.M.
JOSEPHINE COUNTY, OREGON

PREPARED FOR:
MR. CARL EHLIG
291 DOG CR. RD.
SUNNY VALLEY, OR
97497-9715
TEL. 476-5048

PREPARED BY:
GARY D. WICKS, P.E., P.L.S.
CIVIL ENGINEER & LAND SURVEYOR
962 S.E. "N" STREET
GRANTS PASS, OREGON 97526
TEL. 479-3436