


# T.11S., R.2W., W.M.

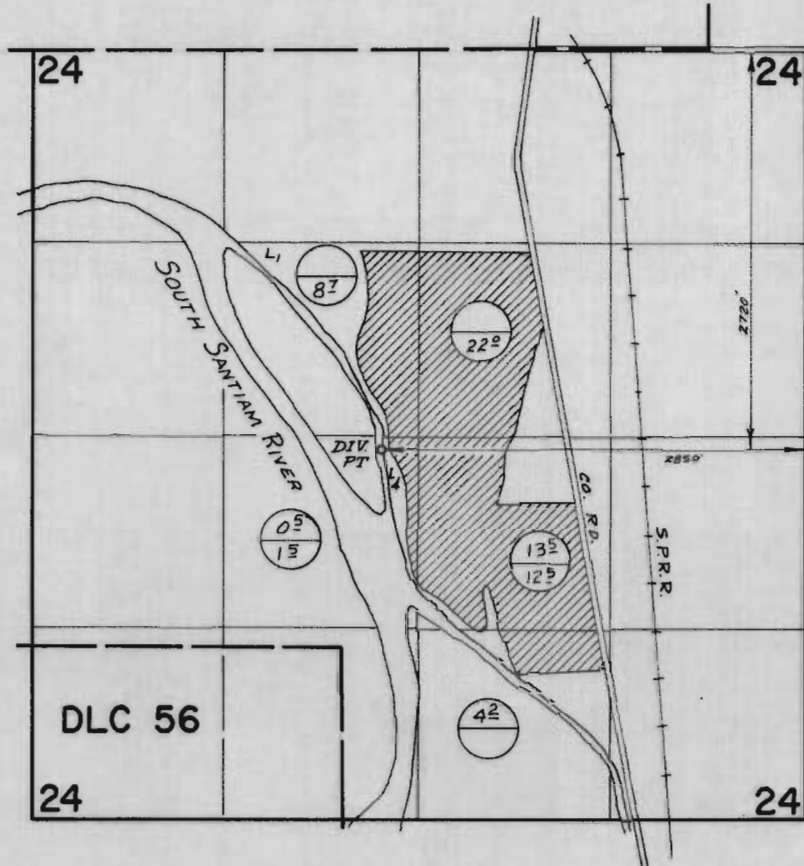

← PERMIT NO. 37070  
← CERTIFICATE NO. 41630

## FINAL PROOF SURVEY UNDER

Application No. 49499 Permit No. 37070  
IN NAME OF

RICHARD H. CARDER

Surveyed April 3 1974, by S.P. Applegate