


T.9 S. R.2 W.W.M.

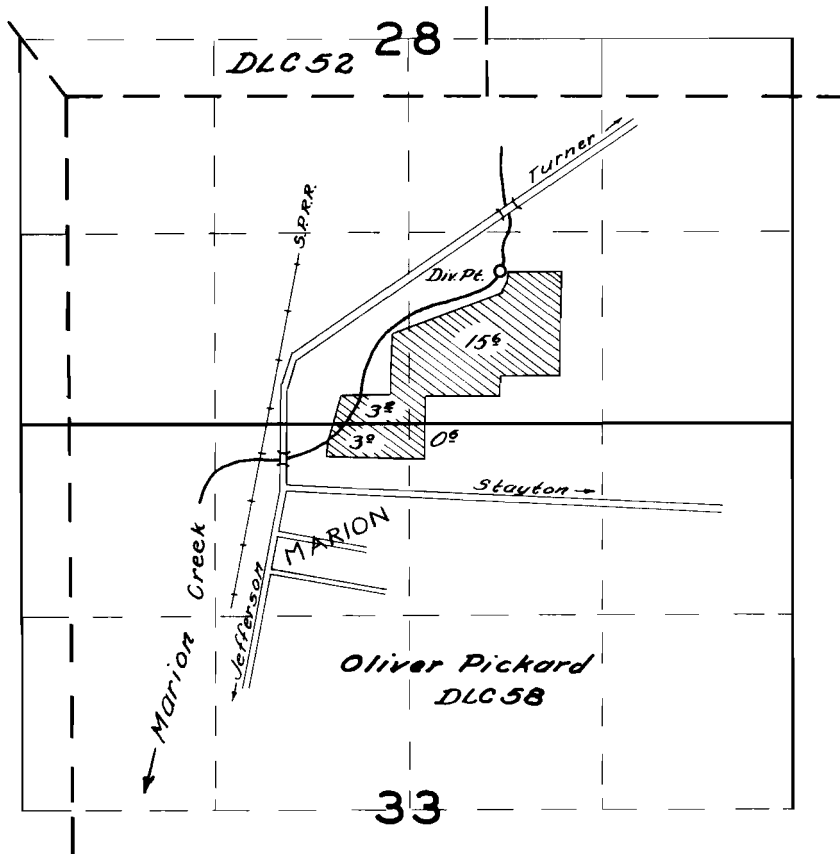

**FINAL PROOF SURVEY**

UNDER

Application No. 26390 Permit No. 20857

IN NAME OF

CLIFFORD W. LAUMAN

Surveyed May 17 1956, by R.H. Whitby