

(NO DAMS OR REGULATING OR CONTROLLING WORKS PRESENT)

WATER USE MAP FOR BENEFICIAL USE PERMIT

EDWARD D. PHELPS + DAMELA R. PHELPS

149 WOLF VALLEY DR., UMPQUA, OR. 97146

PHONE: 459-4476

PERMIT NO: 50705

REFERENCE FILE: 69924



MAY 20 1992

RESOURCES DEPT.  
DN

**RECEIVED**

MAY 13 1991

WATER RESOURCES DEPT  
SALEM, OREGON

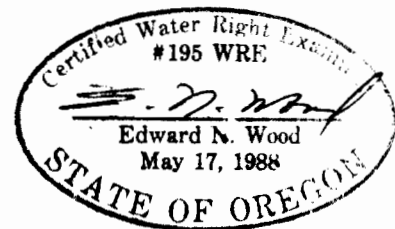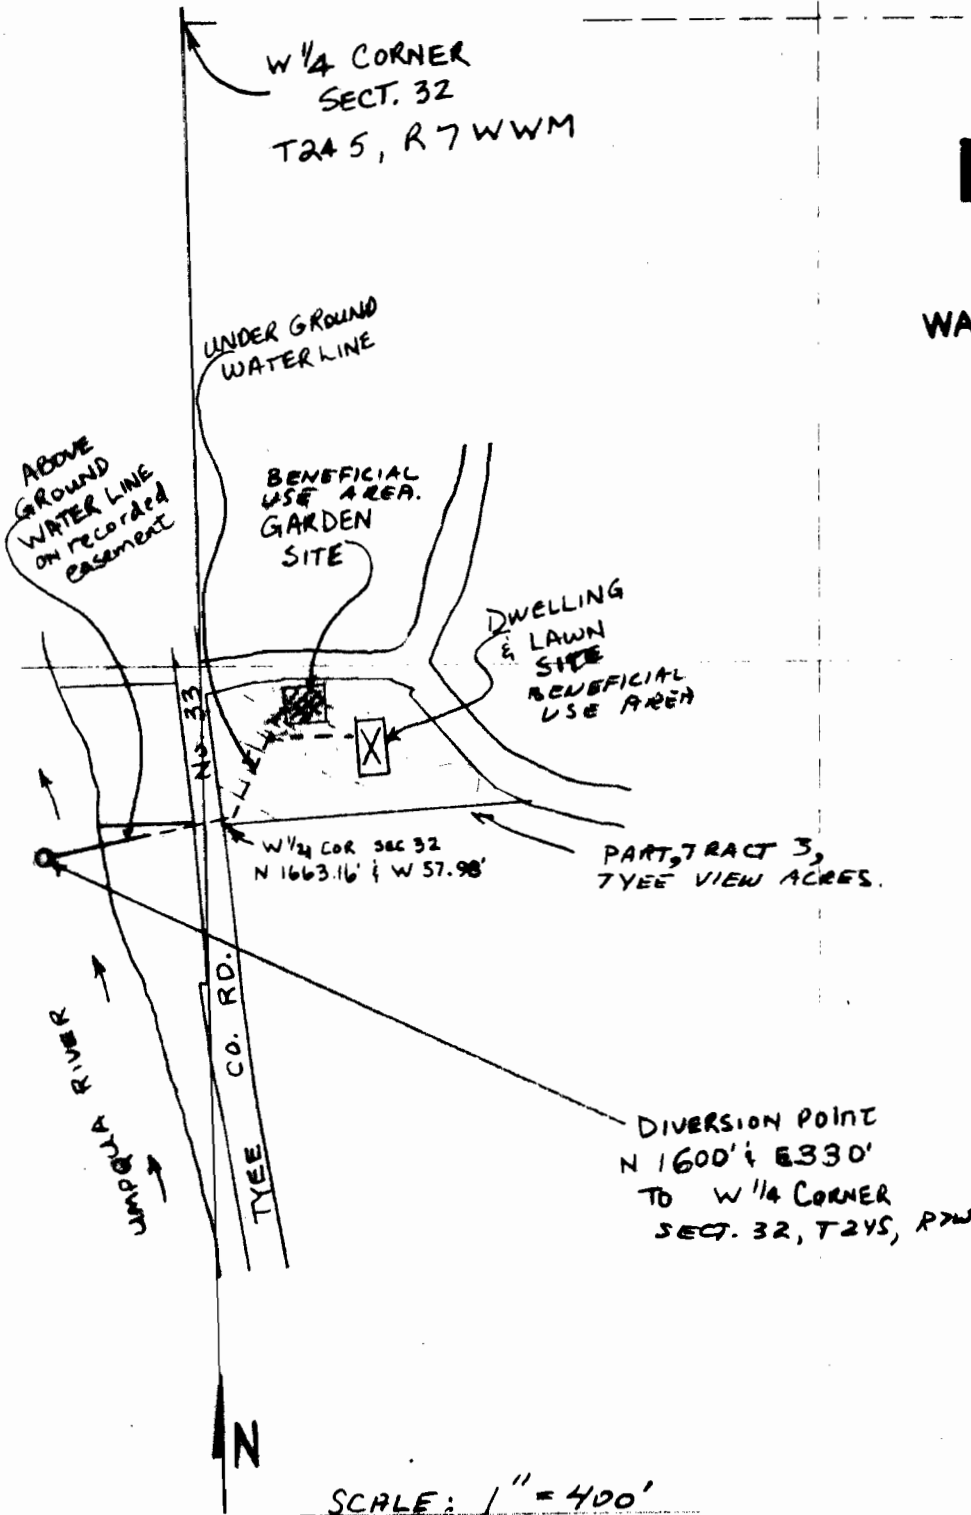

NOT A SURVEY