


T.29S. R.12W. W.M.

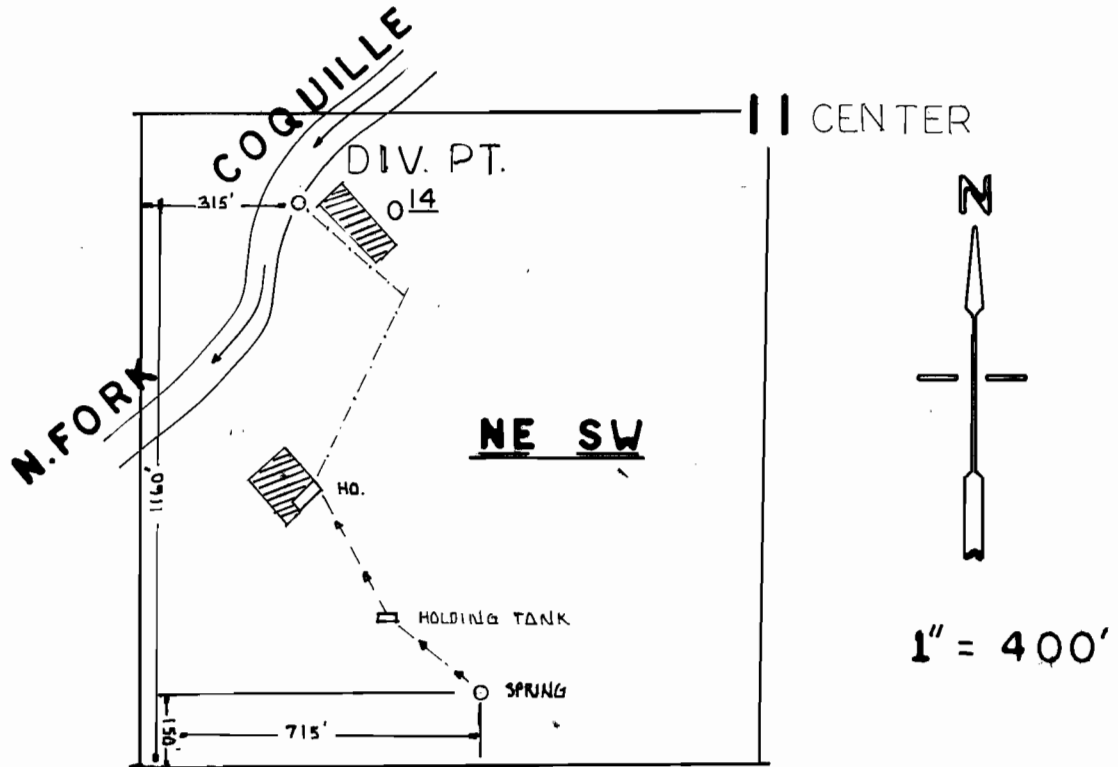

FINAL PROOF SURVEY

UNDER

APPLICATION NO. 69587 PERMIT NO. 50804

**IN THE NAME OF
CLAIR AND RUBY D. FLUKE**

SURVEYED: FEB. 16, 1990

BY: Clair D. Fluke

