

R.39 E. W.M.
R.40 E. W.M.

T.9 S., R.40 E.




FINAL PROOF SURVEY

APPLICATION NO. G-11771
PERMIT NO. G-10922




NOTE: THIS DRAWING DEPICTS SEVERAL ADMINISTRATIVE BOUNDARIES PERTAINING TO THE CITY OF BAKER CITY. THESE BOUNDARIES WERE NOT SURVEYED OR LOCATED AS A PART OF THIS FINAL PROOF SURVEY.

T.9 S. R.39 E. W.M.
T.9 S. R.40 E. W.M.

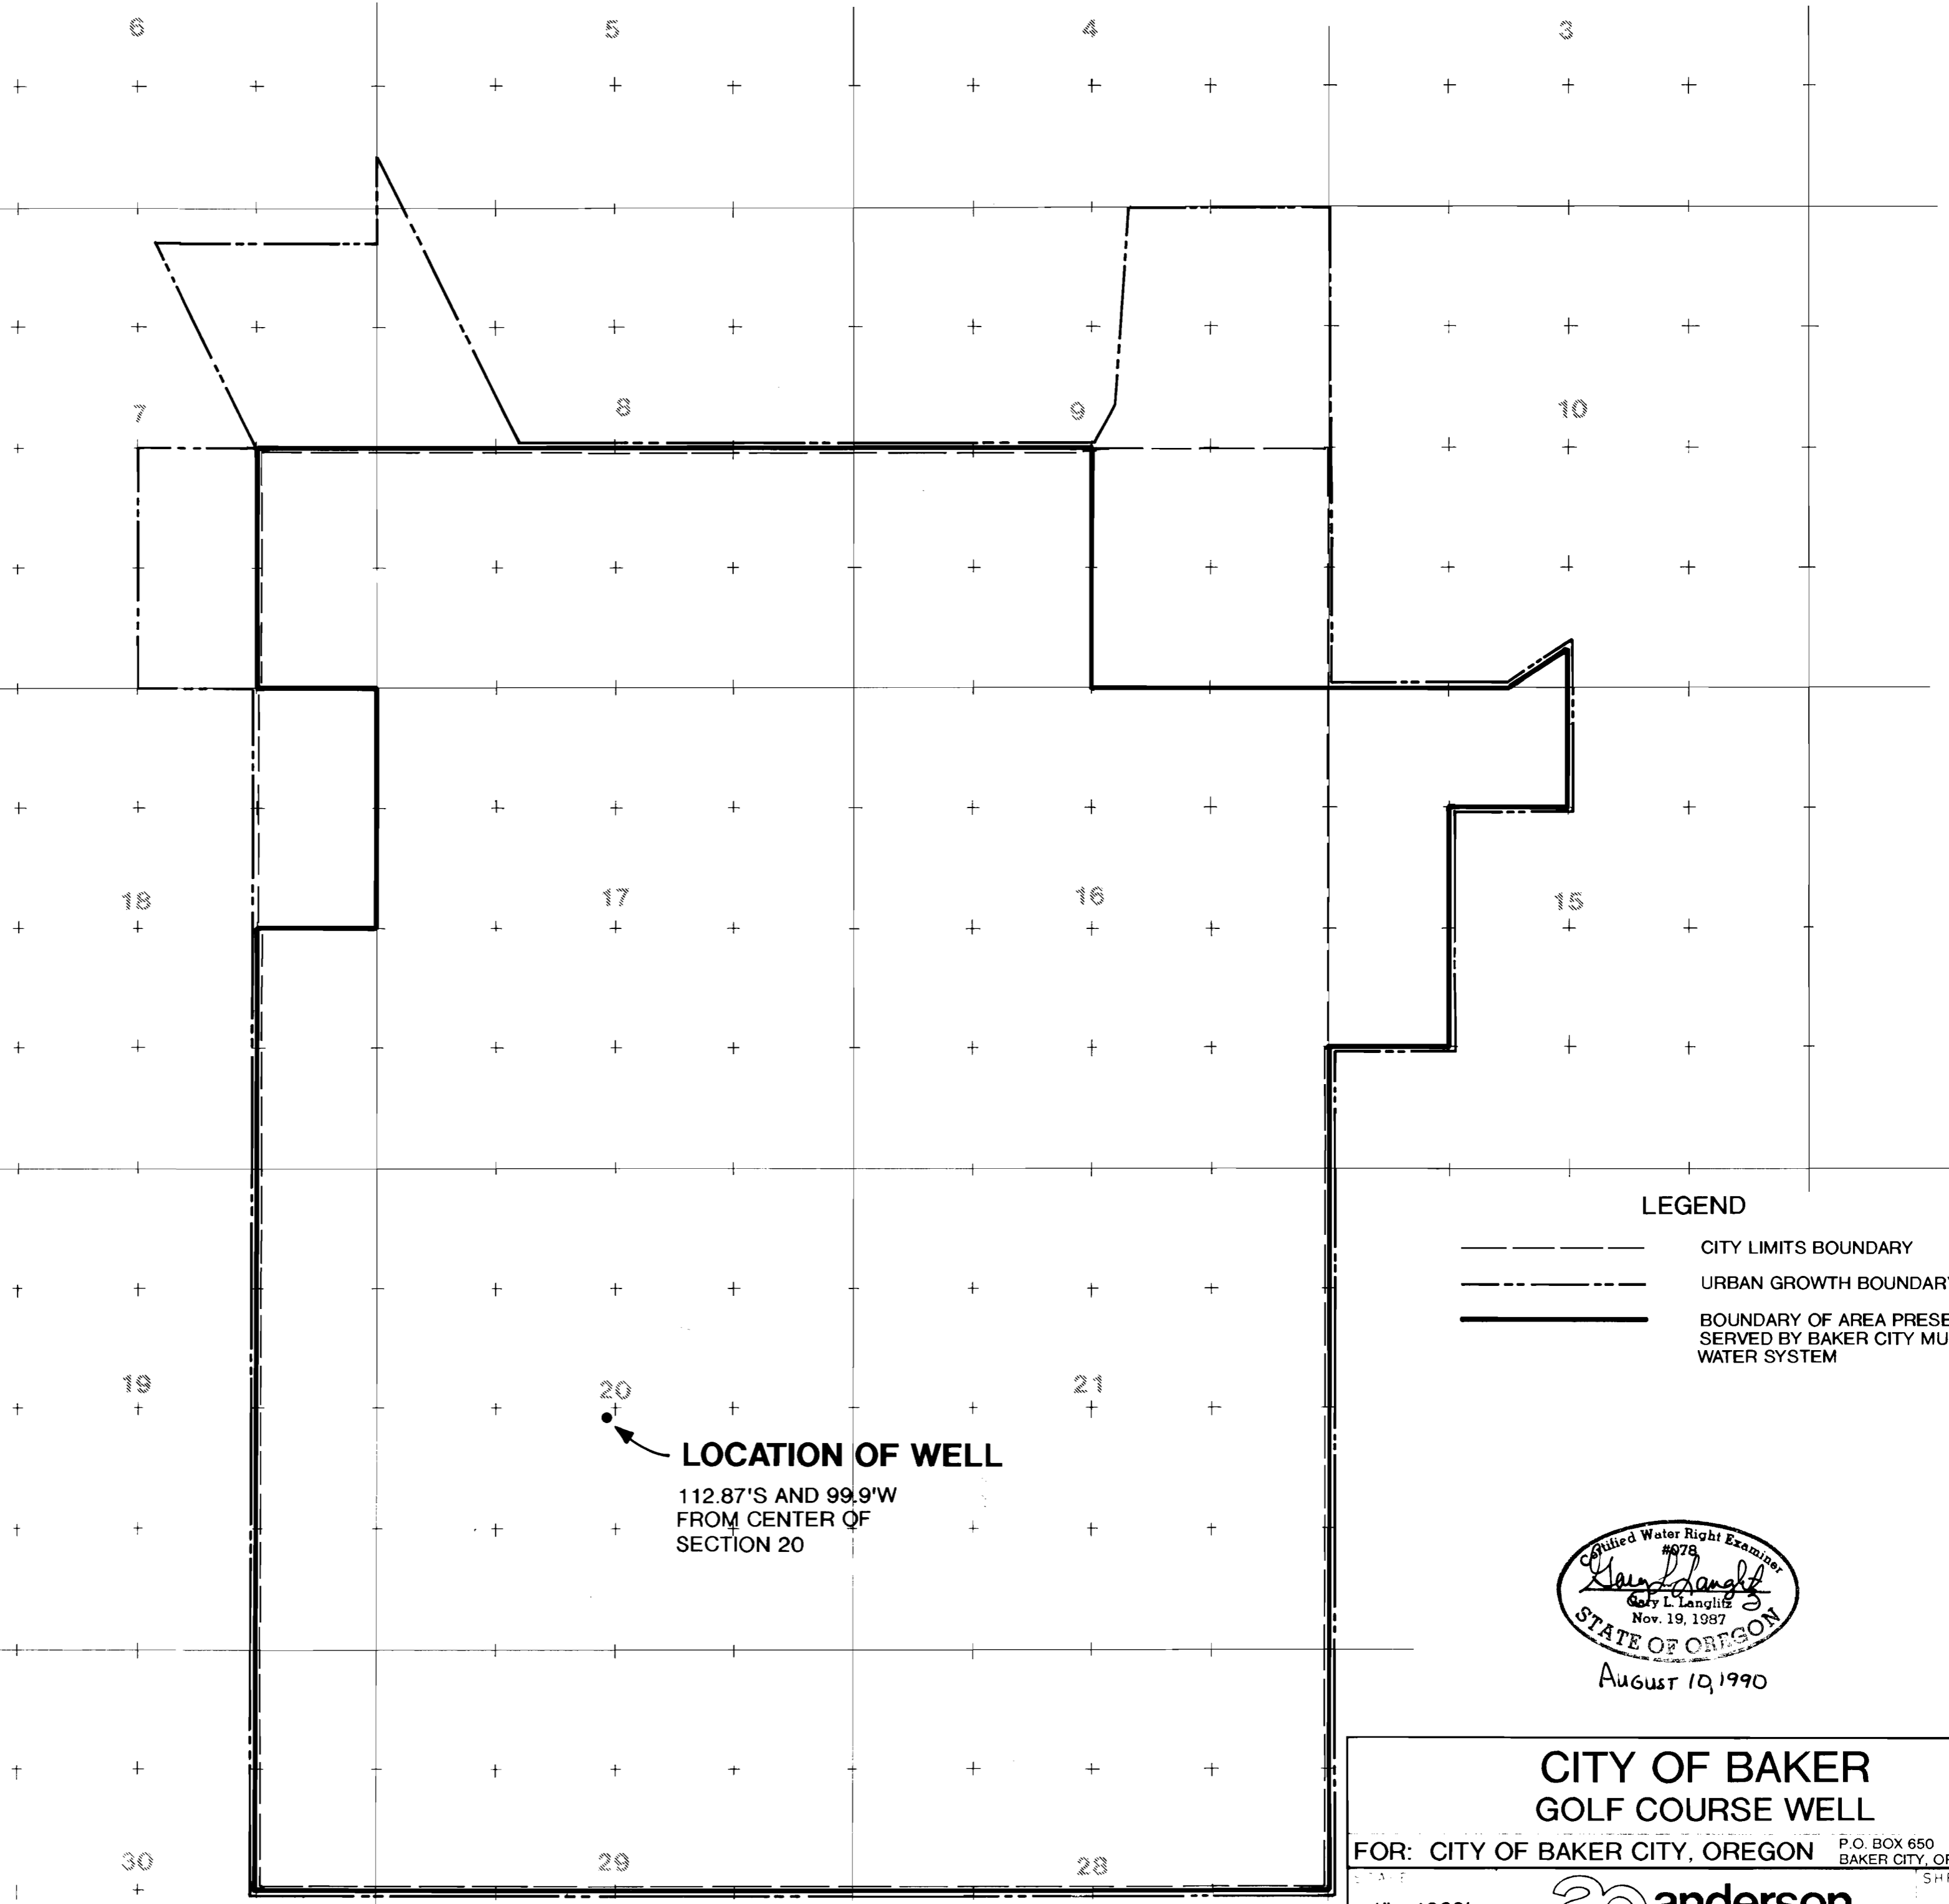BAKER COUNTY

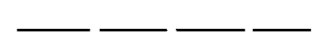

LEGEND

-  CITY LIMITS BOUNDARY
-  URBAN GROWTH BOUNDARY
-  BOUNDARY OF AREA PRESENTLY SERVED BY BAKER CITY MUNICIPAL WATER SYSTEM



CITY OF BAKER
GOLF COURSE WELL

FOR: CITY OF BAKER CITY, OREGON P.O. BOX 650
BAKER CITY, OR. 97814

SCALE
1" = 1320'

DATE
1990



SHEET NO
1

LA GRANGE OR WALLA WALLA WA LEWISTON ID