


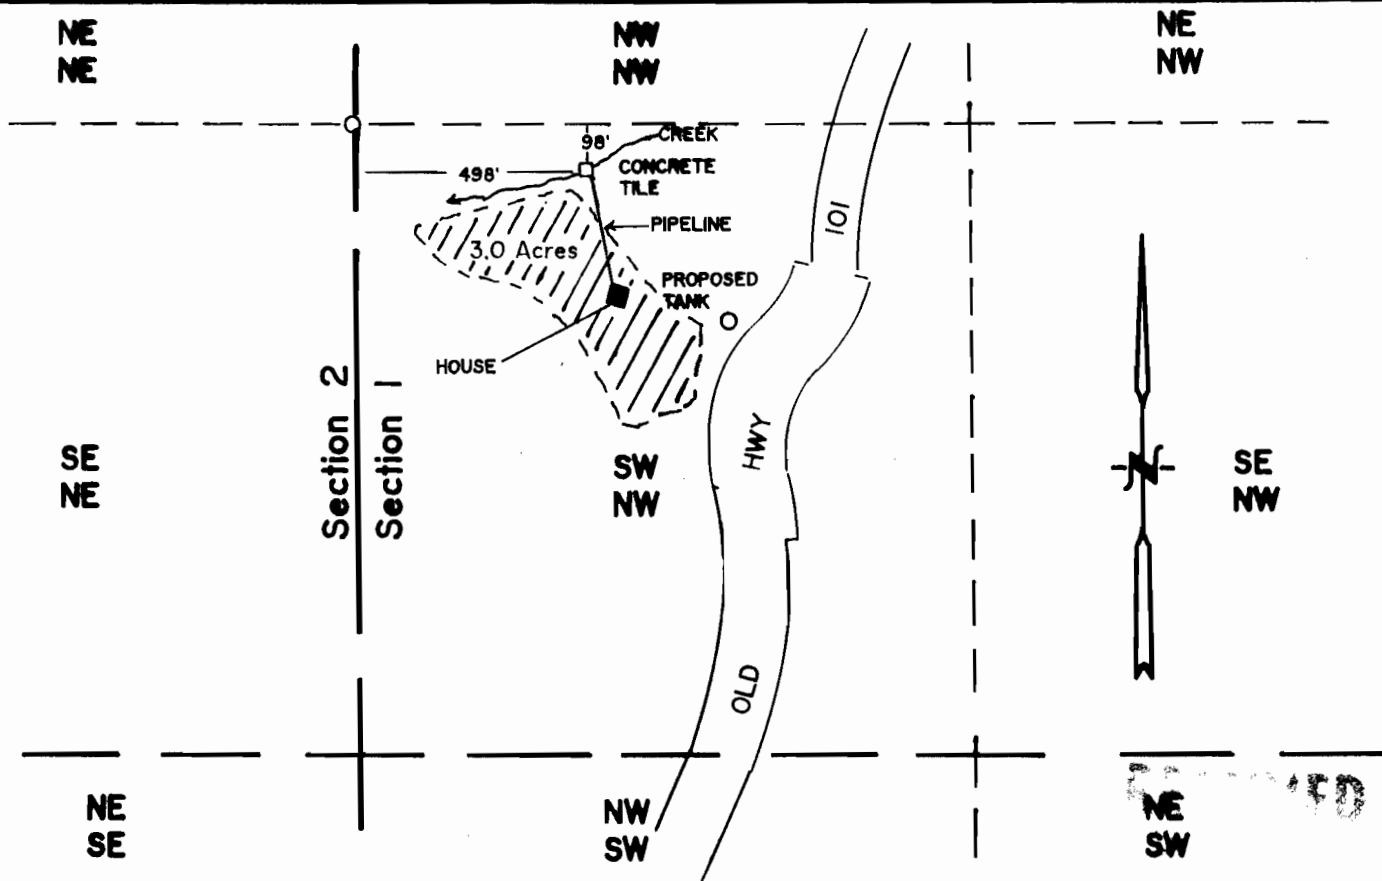

The preparation of this map was for the purpose of identifying the location of the proposed water right and has no intent to provide dimensions or location of property lines.

T 40 S, R 14 W, W.M.,
SECTION 1
FINAL PROOF SURVEY

UNDER

Application # 69223

Permit # 50523

in the name of

G & L GIBBONS LIVING TRUST

Surveyed September 15, 1993 by H.J. Newhouse

Scale 1" = 400'

