


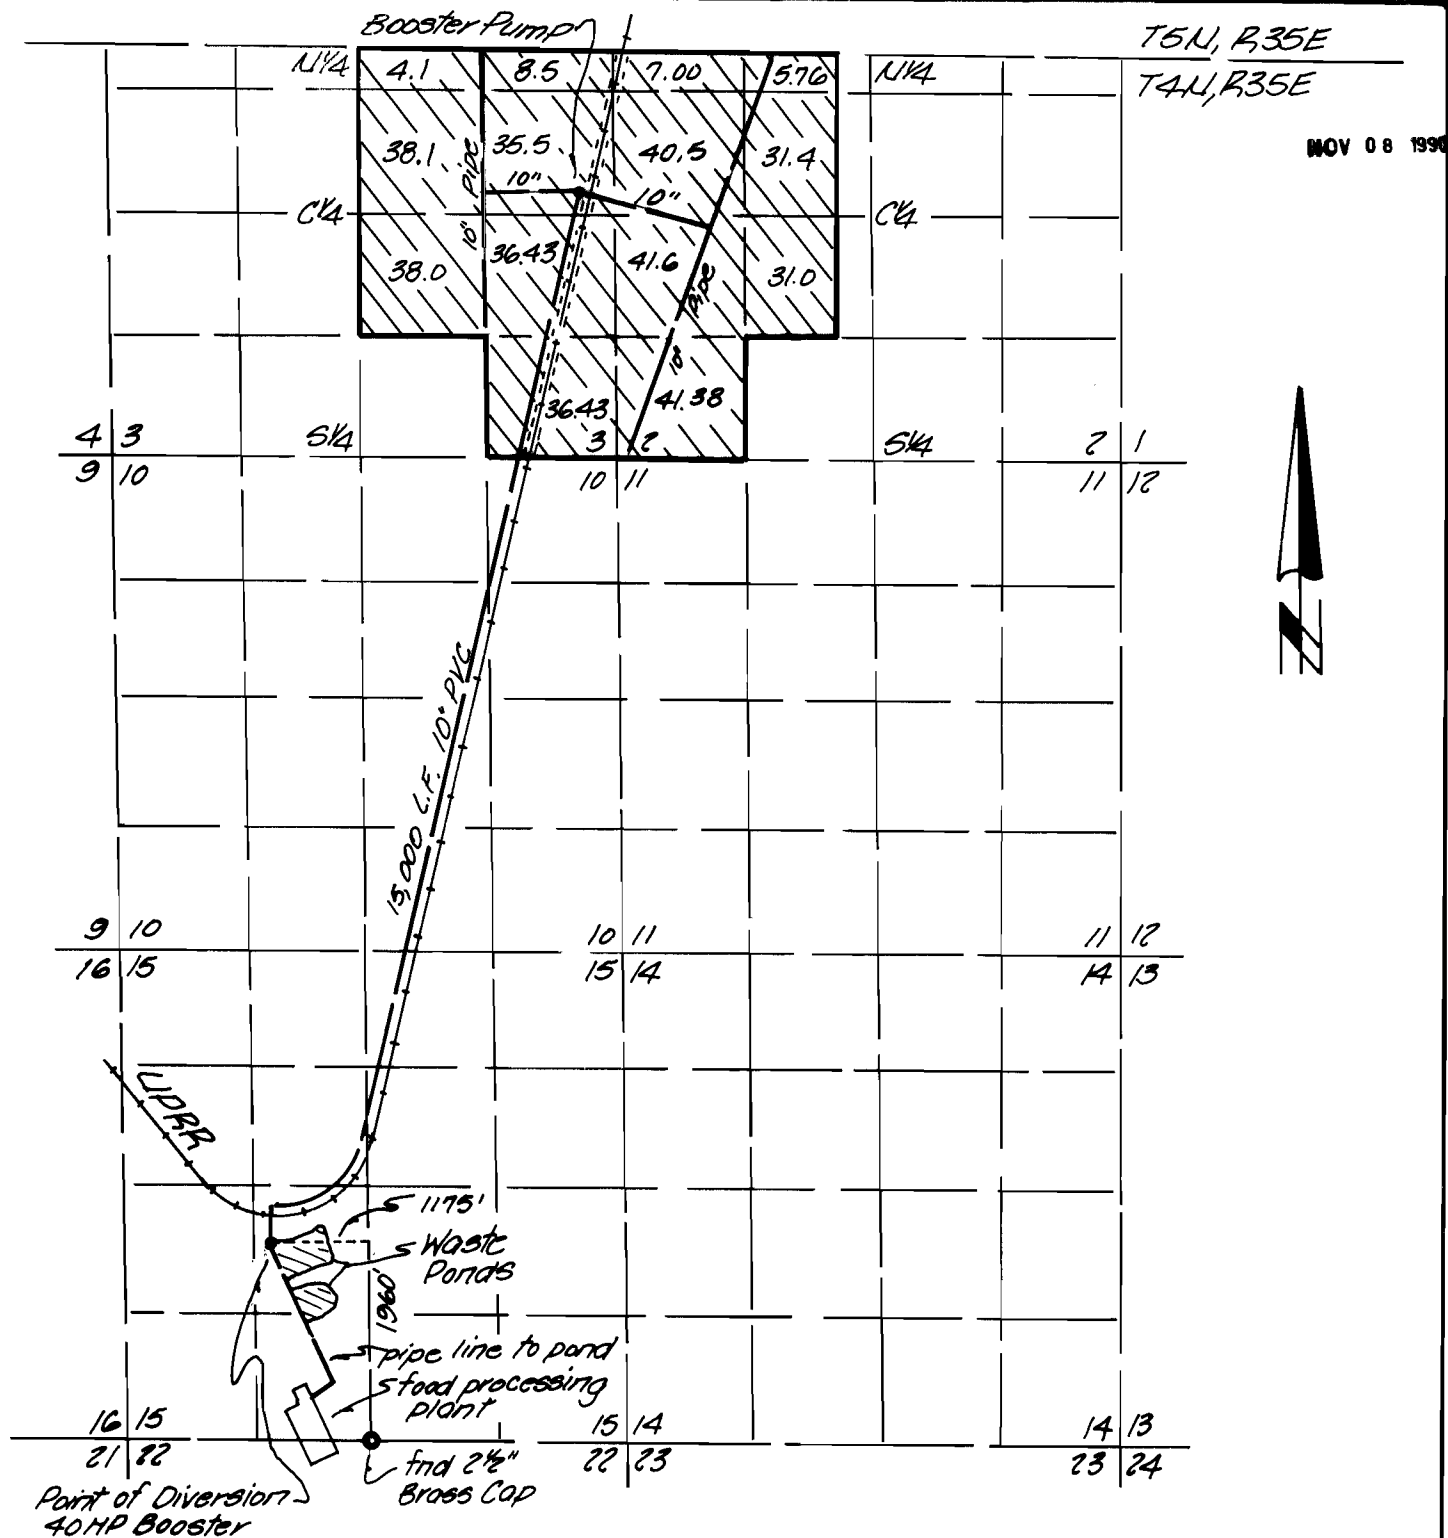

KRUMBEIN ENGINEERING LTD.
ENGINEERS - SURVEYORS - PLANNERS
361 S.E. Second Pendleton, Oregon

Scale
1"=2000'
Date
11-4-90

Drn. By
MLD
Ckd. By
DHK


Drng. No.
90-16A
Job No.
88-06

Revision 1
2-3-91
Revision 2

Final Proof Survey for
Permit No. 50710

HANSELL FARMS

Sec. 243, T4N, R35E, W.M.

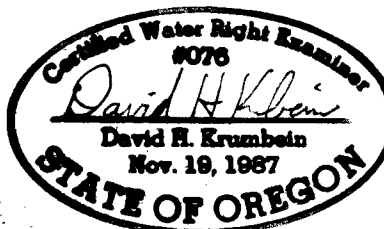

A-69521
P-50710