

T. 6N., R. 35E., W.M.

Umatilla County

Section 34

RECEIVED

JUL 22 1992


WATER RESOURCES DEPT.
SALEM, OREGON



Acres Under Irrigation

Permit No. 51044

Application No. 69869

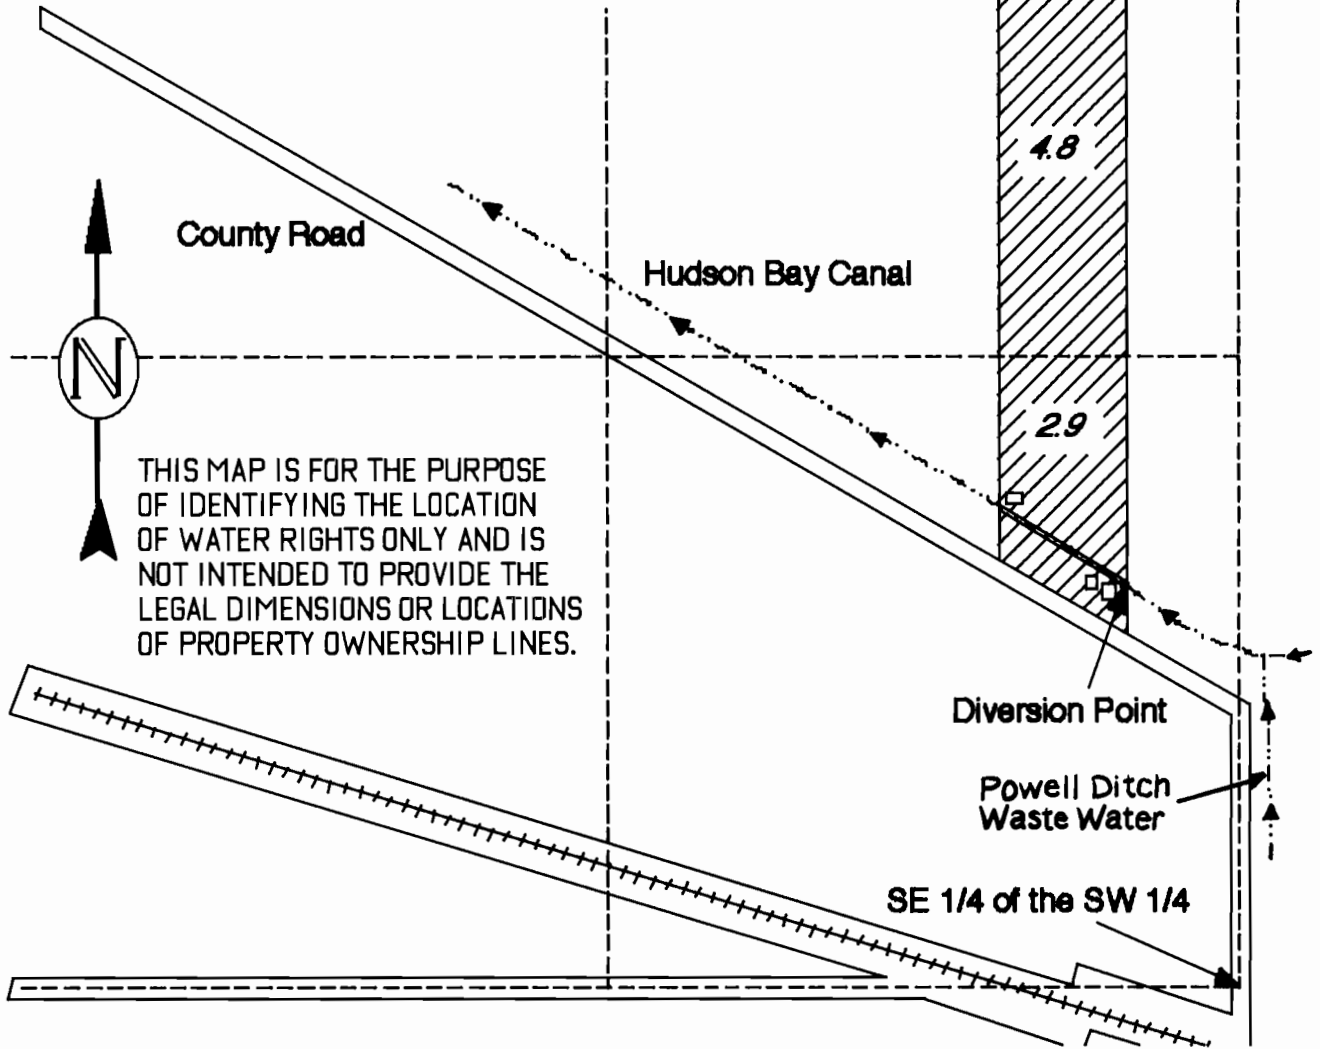

THIS MAP IS FOR THE PURPOSE OF IDENTIFYING THE LOCATION OF WATER RIGHTS ONLY AND IS NOT INTENDED TO PROVIDE THE LEGAL DIMENSIONS OR LOCATIONS OF PROPERTY OWNERSHIP LINES.


Point of Diversion Located 835 Ft North & 228 Ft West of the South 1/4 Corner SE 1/4 of SW 1/4 of Section 34, Township 6 North, Range 35 East W.M.

FINAL PROOF MAP

in Name of

BERT PESCIALLO

SCALE 1"= 400 Ft

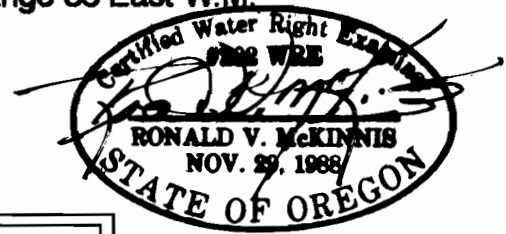

ENGINEERING - SURVEYING - WATER RIGHTS
R V MCKINNIS ENGINEERING
 Rt 1 Box 1122 Hermiston, Oregon 97838
 503-567-2017